

# CERTIFICATE OF LOCATION OF GOVERNMENT CORNER

County of Anoka

State of Minnesota


## West 1/4 Corner of Sec. 34 Township 34 Range 22

On the 2nd day of January, 1975, the described corner was evidenced by a 1" iron pipe

and to perpetuate the location of said corner, at the exact location thereof, a permanent marker was placed consisting of replaced with 2" red and white iron pipe

AND on the 14th day of January, 2022, said permanent marker was found 2" red and white pipe up 3'± and the ties were updated

Updated reference ties are as shown below.

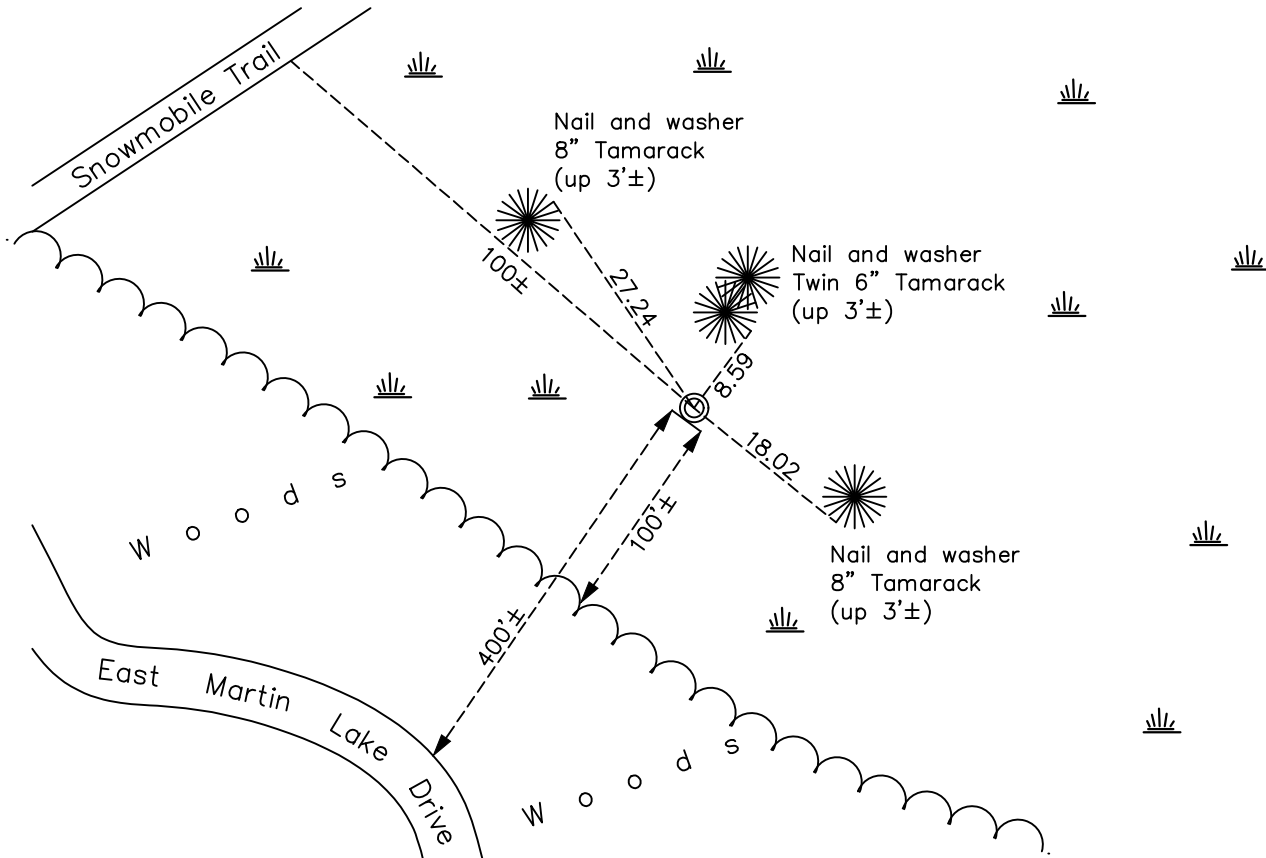

Revision Date  
 03/15/22

N.A.D. 1983 Coordinates  
 (1996 Adjustment)

County Project Coordinates	
Northing	<u>229872.2085</u>
Easting	<u>547784.9670</u>
Date	<u>2/12/04</u>

I hereby certify that this United States public land survey monument record is correct and complete to the best of my knowledge and belief.

*David Zieglermeier* Date 3/25/24

David M. Zieglermeier, Anoka County Surveyor  
 Minnesota License Number 46179

# HISTORY OF GOVERNMENT CORNER

Page No. 36

County of Anoka

State of Minnesota

West 1/4 Corner of Sec. 34 Township 34 Range 22

## **CORNER HISTORY:**

October 1854 - This corner was established by Hiram Taylor, Deputy Surveyor. Taylor marked this position by "set quarter section post" with two bearing trees marked as accessories.

January 2, 1975 - Found 1" iron pipe. Replaced with a 2" red and white iron pipe up 3'±. Established ties.

2/17/78, 7/11/95 - Found 2" red and white iron pipe. Updated ties.

February 12, 2004 - Established NAD 1983(1996 adj.) Anoka County project coordinates by static GPS method.

February 12, 2014 - Found 2" red and white iron pipe up 3'±. Updated ties.

January 14, 2022 - Found 2" red and white iron pipe up 3'±. Verified position by VRS GPS methods. Updated ties.