


SE Cor. Sec. 6, T33, R25

Set 1" x 10' Iron Pipe. Top 3' Painted with alternate Red and white Bands and up 3'

8 Jan. 1964

J. Oliver  
M.D. ANDERSON  
M. Nordin

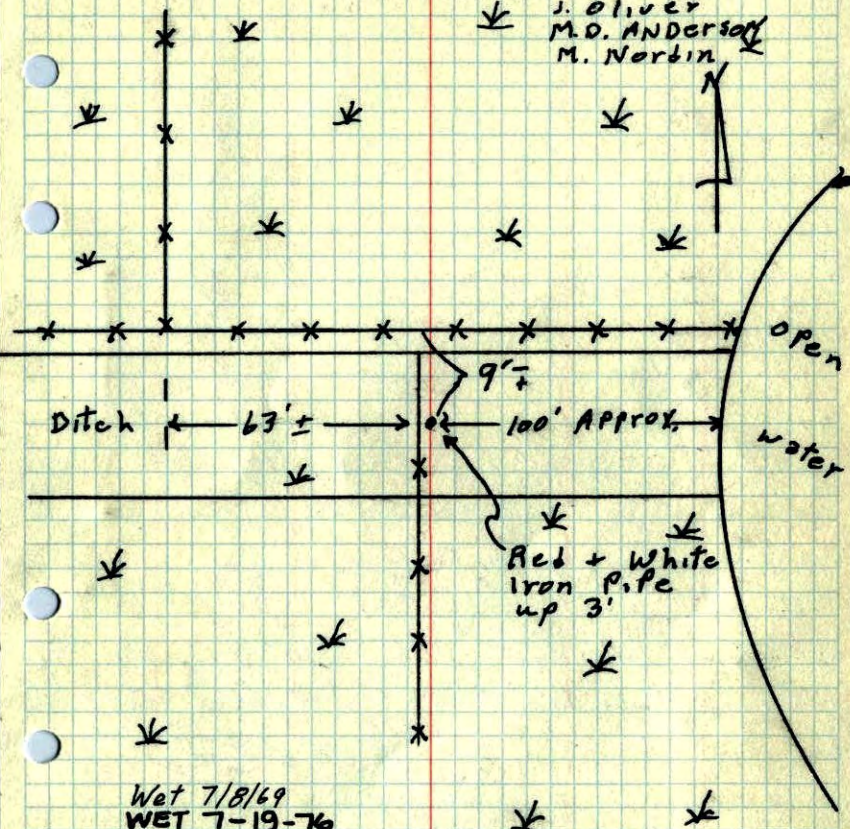

Wet 7/8/69  
WET 7-19-76  
WET 73  
WET 1982

TEMPERATURE CORRECTED  
AND HORIZONTALLY  
TAPED MEASUREMENTS

ROLAND W. ANDERSON  
COUNTY SURVEYOR  
ANOKA COUNTY, MINNESOTA

SE Cor. Sec. 6, T33, R25

Set 1" x 10' Iron Pipe. Top 3' painted with alternate Red and white Bands and up 3'

8 Jan 64  
J. Oliver  
M.D. Anderson  
M. Nordin

