

CERTIFICATE OF LOCATION OF GOVERNMENT CORNER

County of Anoka

State of Minnesota


Witness Corner Sec. 6, Township 33, Range 25

On the South Line of the Southeast Quarter of Sec. 6
I hereby certify that on the 1st day of June, 1976, I found the described corner which was

evidenced by Area Resurvey

and I further certify that to perpetuate the location of said corner, I did, at the exact location thereof, place a permanent marker consisting of a cast iron monument with a sign and post on the north side

which reference or witness monuments are located in the manner following:

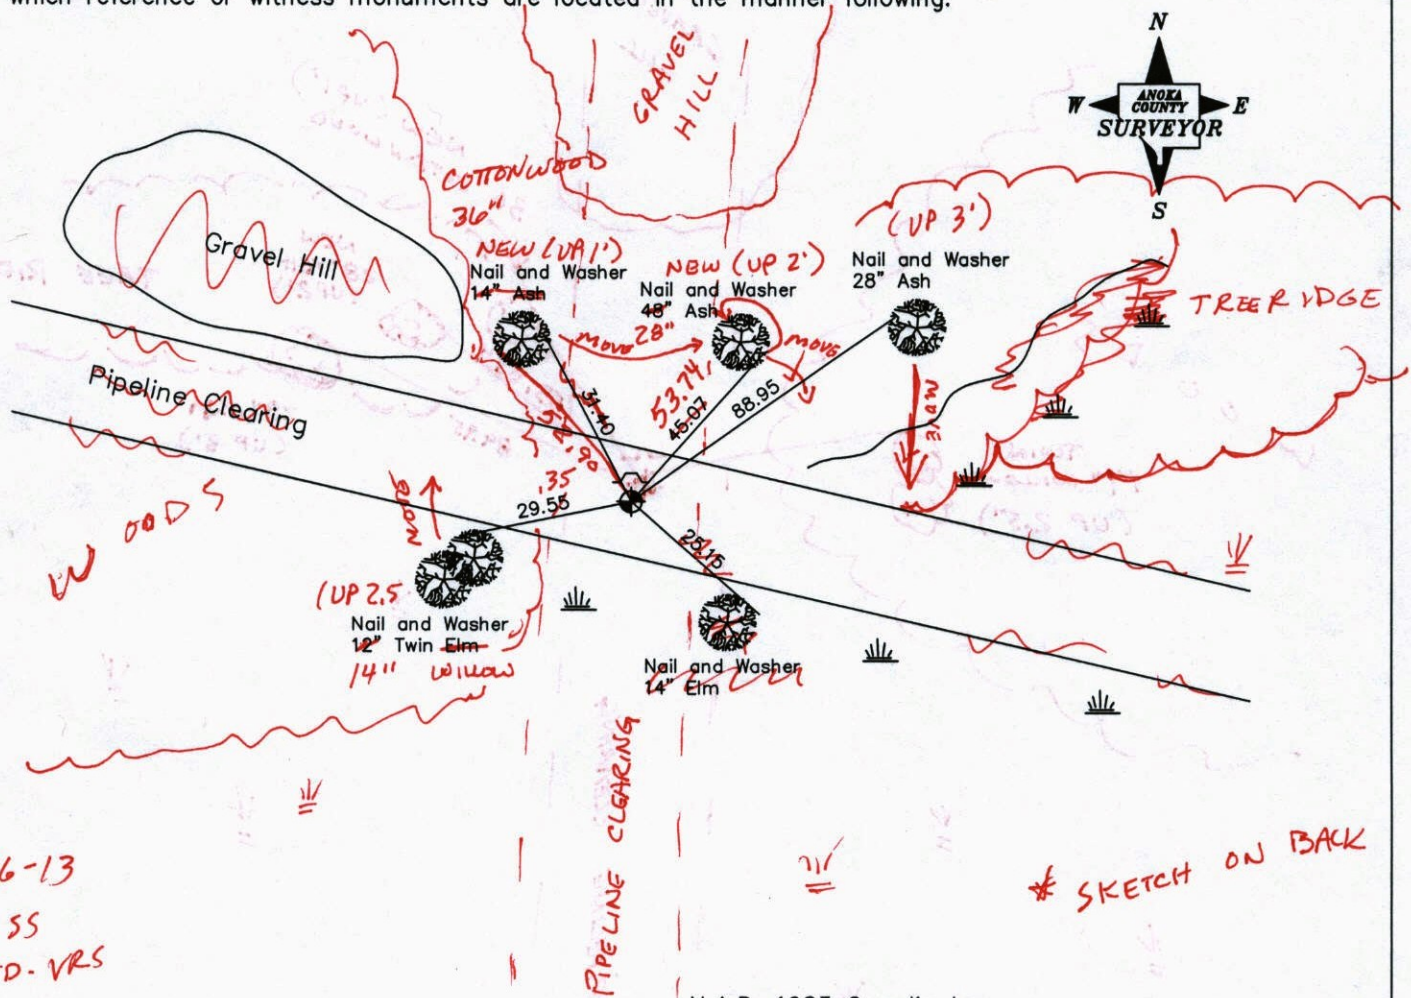

3-26-13
BK-SS
TAPED-VRS

* SKETCH ON BACK

Revised date

8-29-89 HL
1-28-03

N.A.D. 1983 Coordinates
(1996 Adjustment)

County Project Coordinates		State Plane Coordinates	
Northing	222664.4348	Y	_____
Easting	441758.3412	X	_____


Date 1-28-03

3D = 0.07 N = 222664.2971 E = 441758.2967




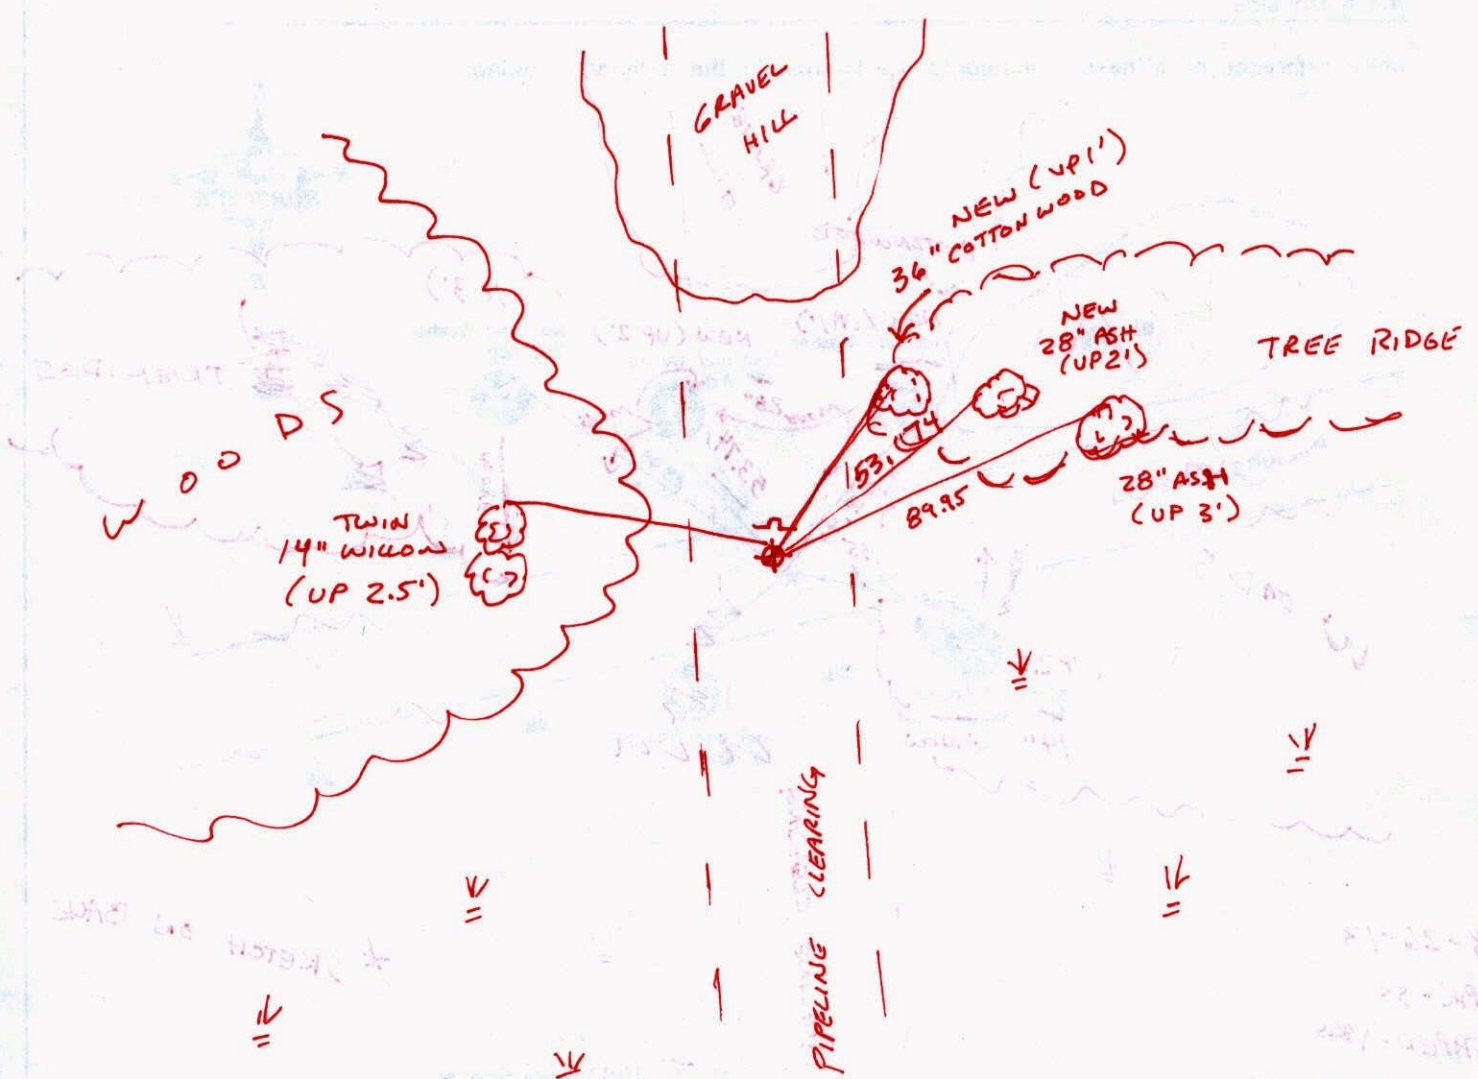

CERTIFICATE OF LOCATION OF GOVERNMENT CORNER

County of Anoka

State of Minnesota

Witness Corner Sec. 6, Township 33, Range 25


On the South Line of the Southeast Quarter of Sec. 6

I hereby certify that on the 1st day of June, 1976, I found the described corner which was

evidenced by Area Resurvey

and I further certify that to perpetuate the location of said corner, I did, at the exact location thereof, place a permanent marker consisting of a cast iron monument with a sign and post on the north side

which reference or witness monuments are located in the manner following:

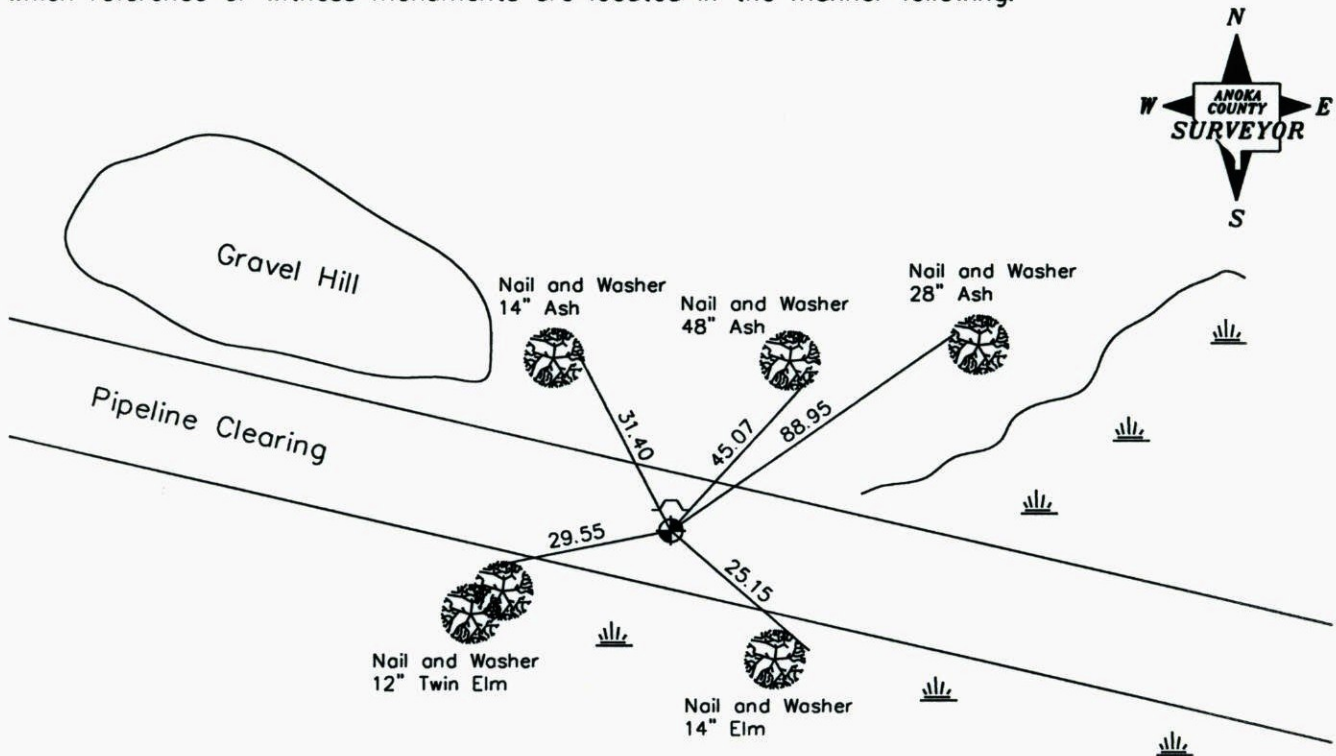

Revised date

8-29-89 HL
1-28-03

N.A.D. 1983 Coordinates
(1996 Adjustment)

County Project Coordinates	
Northing	<u>222664.4348</u>
Easting	<u>441758.3412</u>

State Plane Coordinates	
Y	_____
X	_____

Date 1-28-03

CERTIFICATE OF LOCATION OF GOVERNMENT CORNER


County of Anoka State of Minnesota

WC ON S. LINE of SOUTHEAST 1/4 Corner of Sec. 6 Township 33 Range 25


I hereby certify that on the 1 day of JUNE, 1976, I found the described corner which was evidenced by AREA RESURVEY

and I further certify that to perpetuate the location of said corner, I did, at the exact location thereof, place a permanent marker consisting of CAST IRON MONUMENT WITH SIGN AND POST ON NORTH SIDE

which reference or witness monuments are located in the manner following:

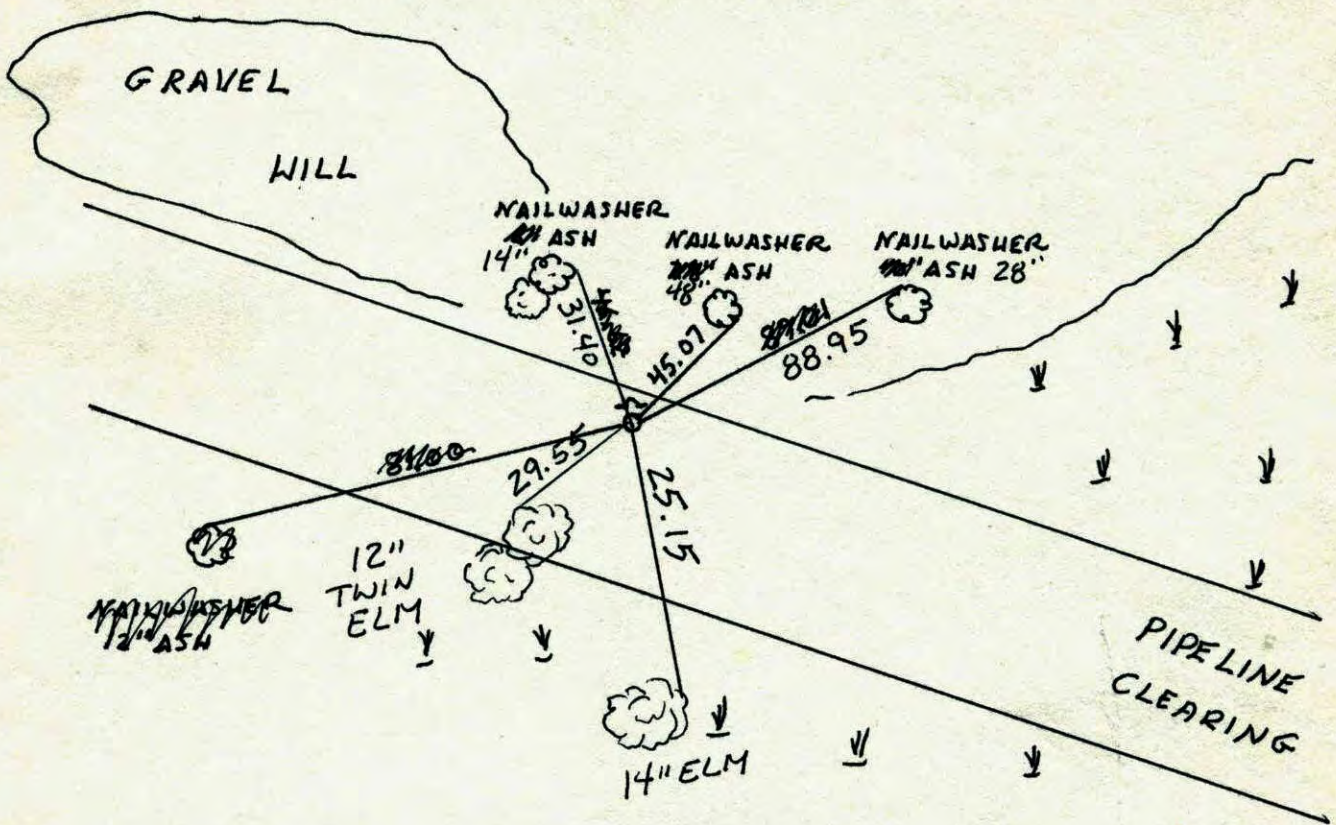


Revised date	Revised date	Revised date
8-29-89 HL		
1-28-03		

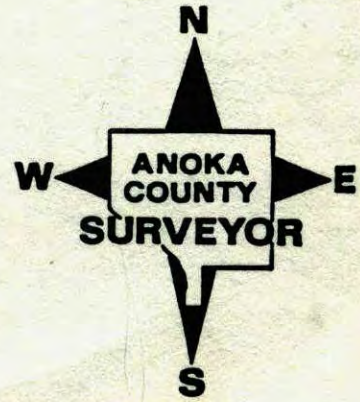

W.C. ON SOUTH LINE OF SE 1/4 SEC. 6 T33 R25

RESET FROM AREA RESURVEY

C.I. FLUSH WITH SIGN & POST ON NORTH SIDE

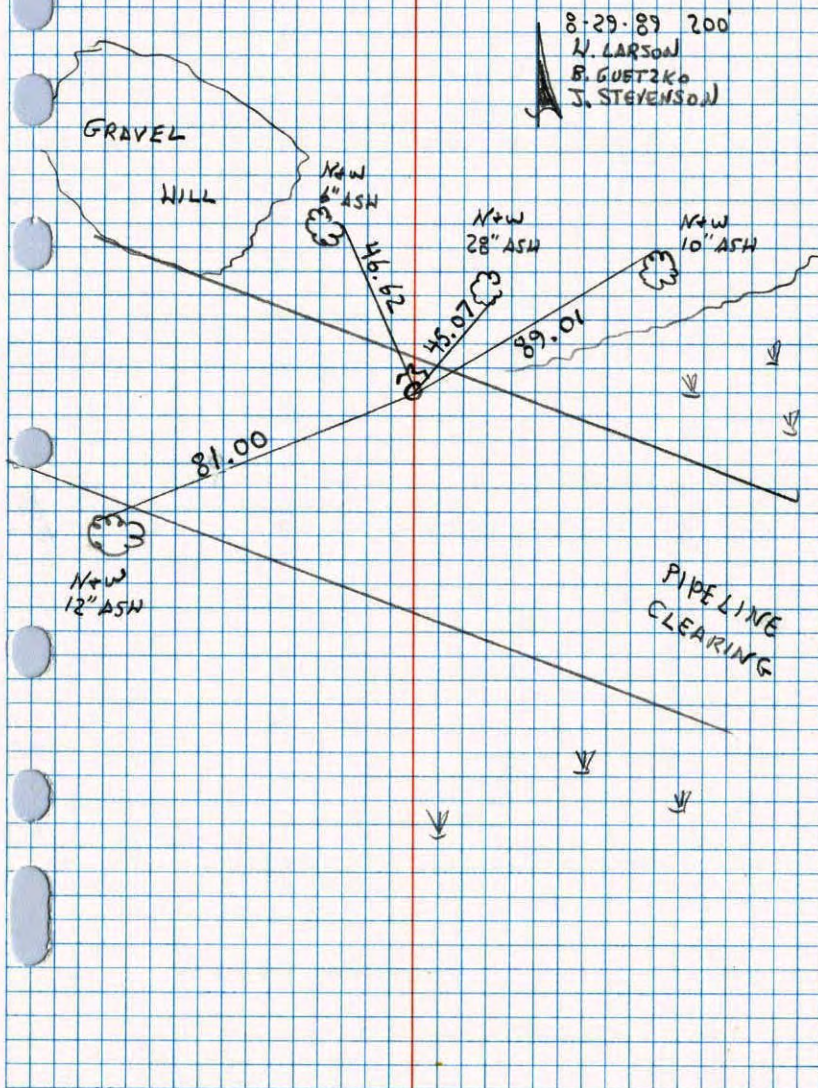

NO. 448

TELEPHONE


30 A

South SE 6

W.C. On North Line Of NE 1/4 Sec 6 T33 R25

Set Cast Iron Monument From Area Resurvey

Cast Iron Flush With Sign & Post On South Side

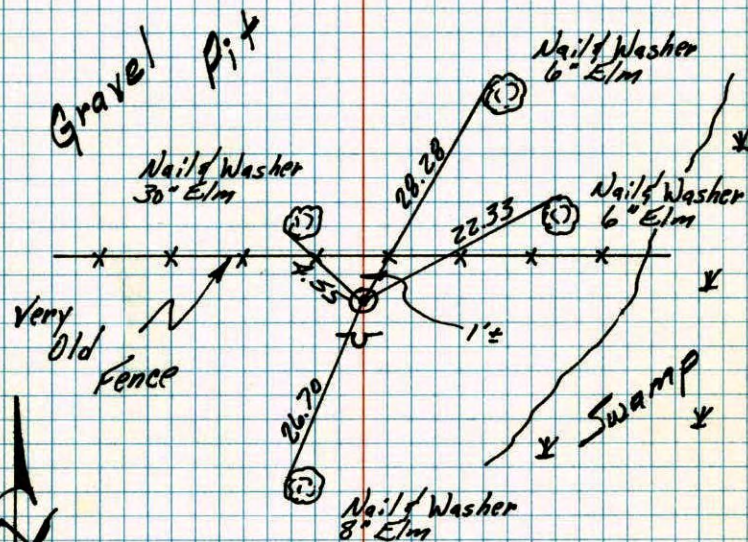

6-1-76
N. Larson
B. Gustako

TIE CHECK
8-4-82
P. Ross
P. Hornby

7-17-79
TIE CHECK
B. STEPHENS
D. STEPHENS
P. ROSS

TEMPERATURE CORRECTED
AND HORIZONTALLY
TAPED MEASUREMENTS


ROLAND W. ANDERSON
COUNTY SURVEYOR
ANOKA COUNTY, MINNESOTA

W.C. on ~~the~~ ^S Line of ~~the~~ ^{SE} ~~1/4~~ ⁶ Sec 7 T33 R25

set cast iron monument from area
resurvey. all flush with sign + post
on S. side.

6-2-76
76° #7
H. Larson
B. Guetako

Gravel Pit

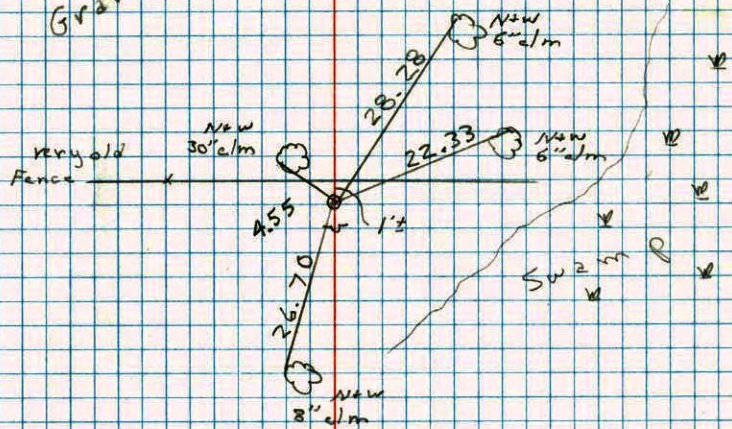

16.30
7/6
1/2
00