

CERTIFICATE OF LOCATION OF GOVERNMENT CORNER

County of Anoka



State of Minnesota

West 1/4 Corner of Sec. 15, Township 33, Range 25

I hereby certify that on the 6th day of December, 1974, I found the described corner which was evidenced by Area Resurvey

and I further certify that to perpetuate the location of said corner, I did, at the exact location thereof, place a permanent marker consisting of a cast iron monument with a sign and post on the north side

which reference or witness monuments are located in the manner following:

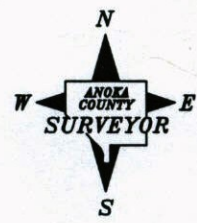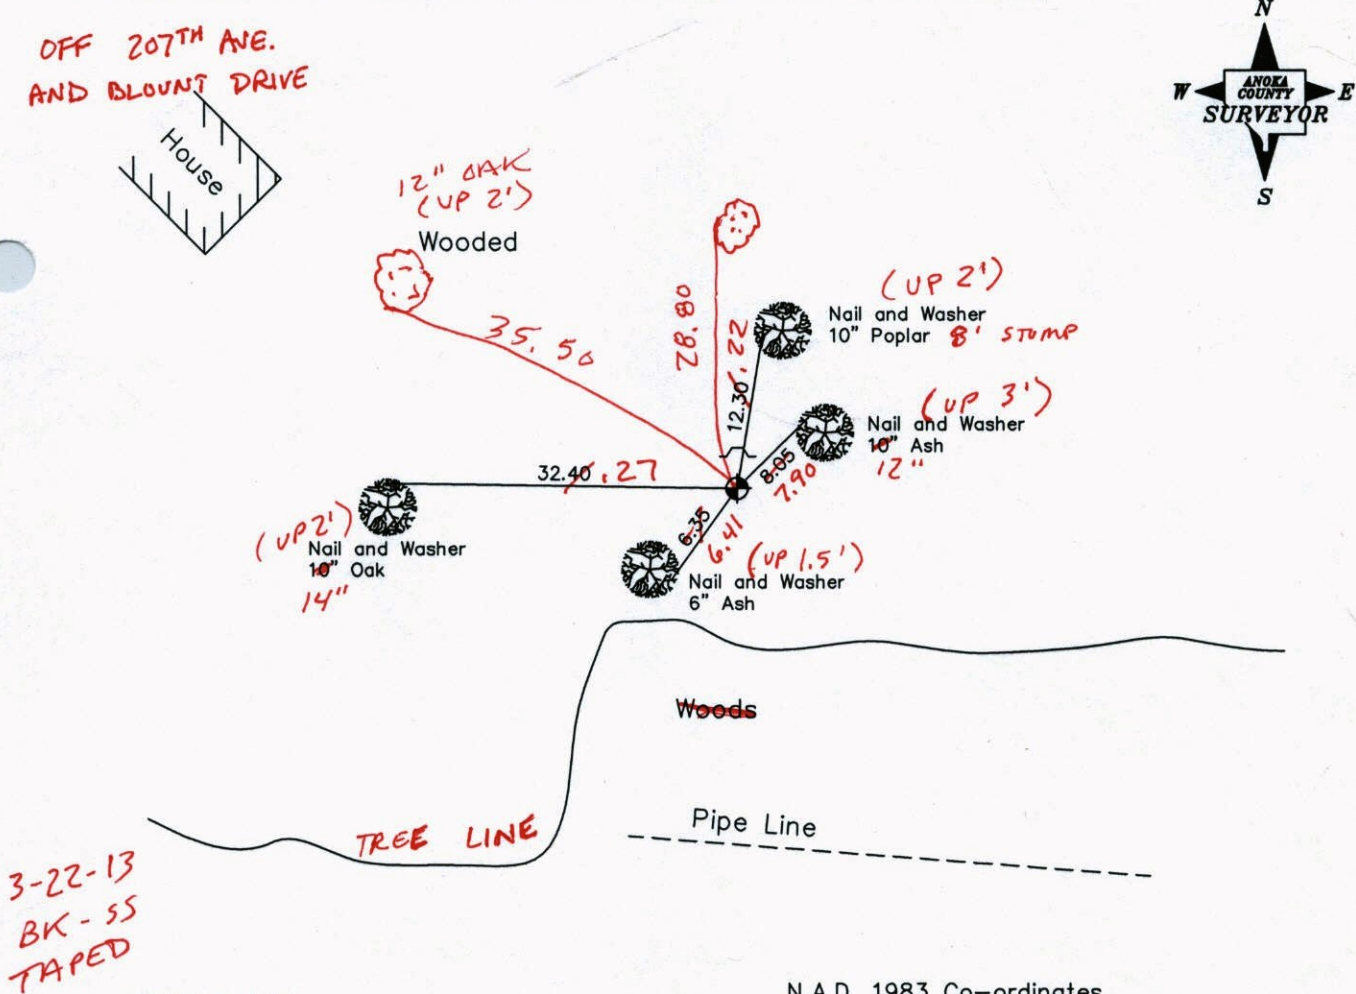

Revised date

7-2-85
6-27-89
7-19-94
2-13-03

N.A.D. 1983 Co-ordinates
(1996 Adjustment)

County Project Co-ordinates		State Plane Co-ordinates	
Northing	214626.7649	Y	_____
Easting	452870.1067	X	_____

Date 2-13-03

CERTIFICATE OF LOCATION OF GOVERNMENT CORNER

County of Anoka


State of Minnesota

WEST 1/4 Corner of Sec. 15 Township 33 Range 25


I hereby certify that on the 6 day of DECEMBER, 1974, I found the described corner which was evidenced by AREA RESURVEY

and I further certify that to perpetuate the location of said corner, I did, at the exact location thereof, place a permanent marker consisting of CAST IRON WITH SIGN & POST ON NORTH SIDE.


which reference or witness monuments are located in the manner following:

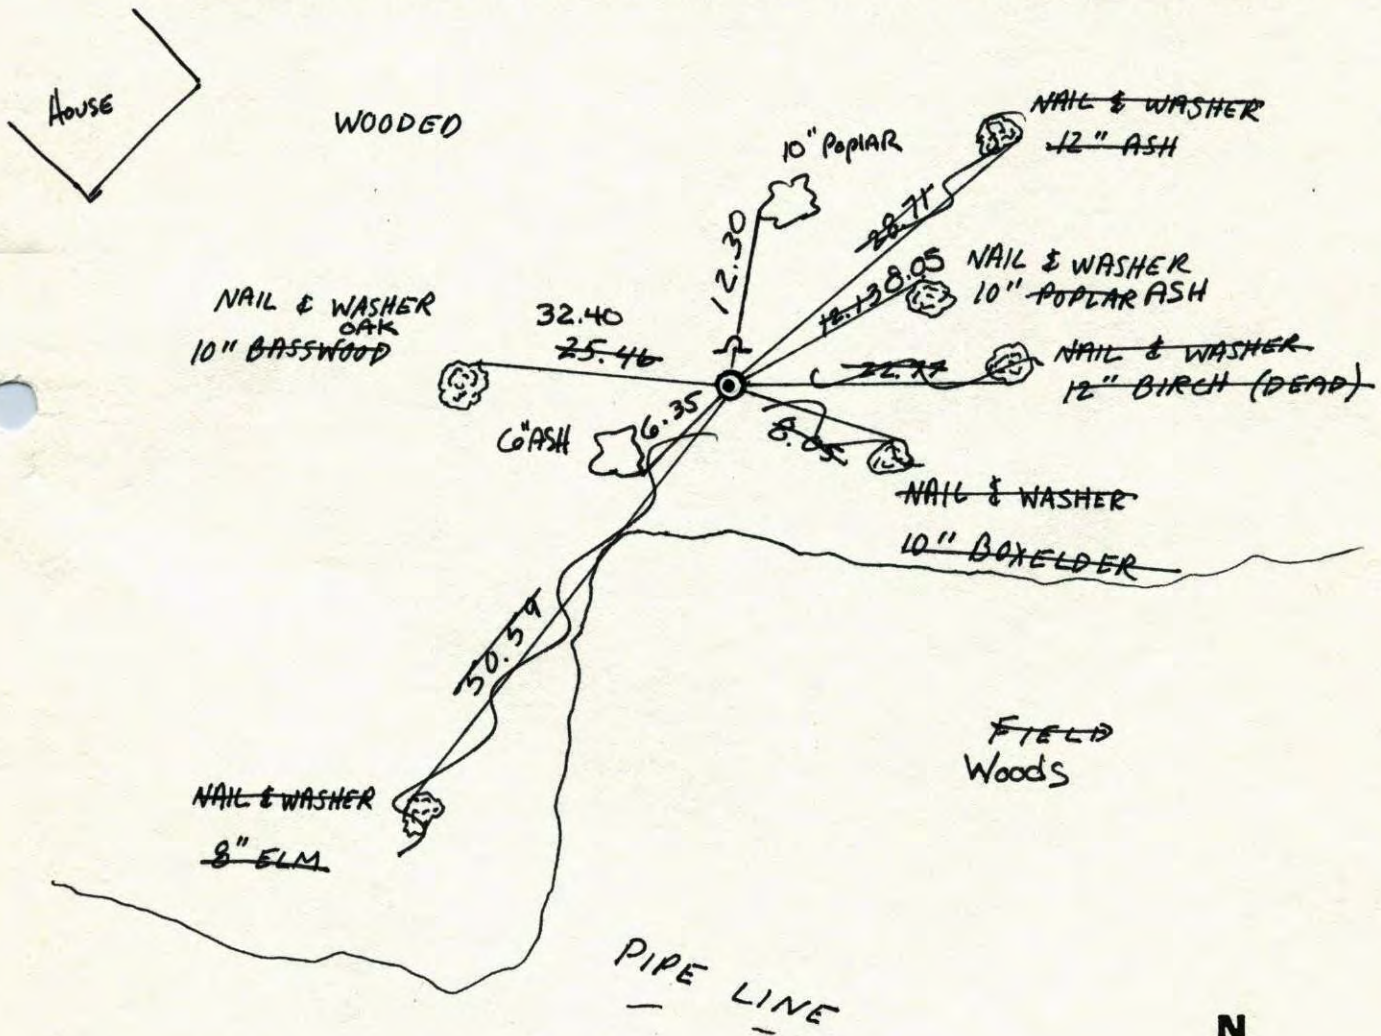

Revised date	Revised date	Revised date
7-2-85		
6-27-89		
7-19-94		
2-13-03		

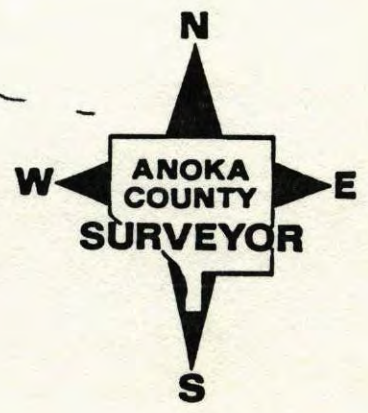


WEST 1/4 CORNER SEC 15 T33 R25

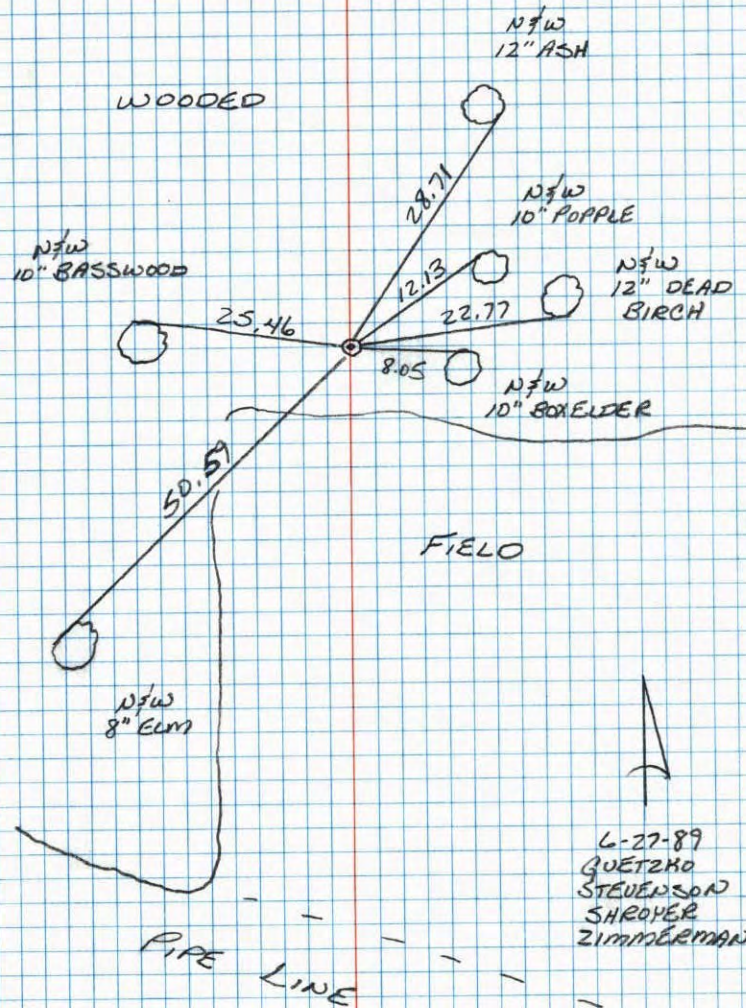RETIRED CAST IRON MONUMENT SIGN
AND POST ON THE NORTH SIDE

NO. 448

TELEPHONE

W 1/4 Cor. Sec 15-T33-R25

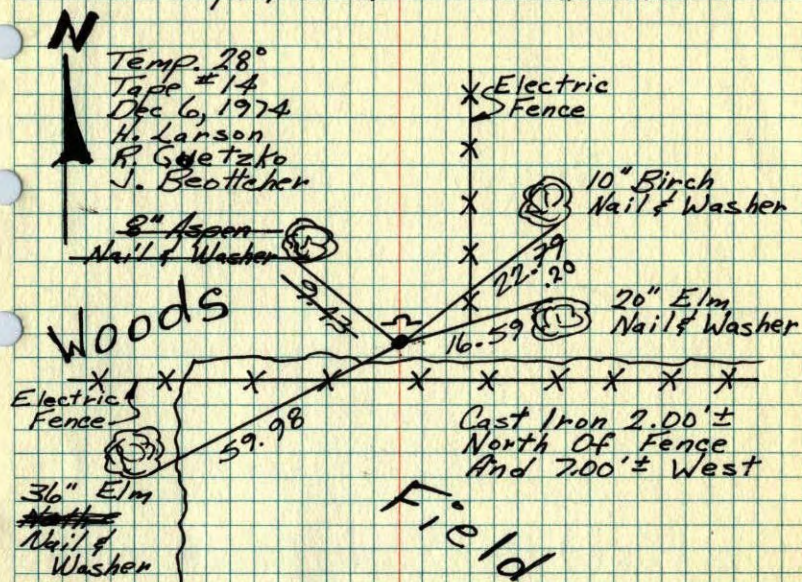Set Cast Iron Monument From Area Resurvey.
Set Sign & Post On North Side.TIE CHECK
8-5-82
P. ROSS
P. HORNBYTIE CHECK
7-22-76
G. ADAMS
S. BRIEN
J. STEPHENSTIE CHECK
7-18-77
B. STEPHENS
D. STEPHENS
P. ROSSROLAND W. ANDERSON
COUNTY SURVEYOR
ANOKA COUNTY, MINNESOTATEMPERATURE CORRECTED
AND HORIZONTALLY
TAPED MEASUREMENTS

W¹/₄ Cor. Sec. 15 T33 R25

Set cast iron monument from area resurvey.

Set sign & post on N. side.

28° ± 14
12-6-74

H. Larson
J. Blotcher
B. Guetzko

