


S.E. Cor. Sec. 25-33-25 ⁹⁸

Found 0.4' x 0.6' Field Stone
 Stone fits Old Cartwright ties
 replaced stone with 3/4" Iron Pipe
 replaced I.P. with cast iron monument
 flush

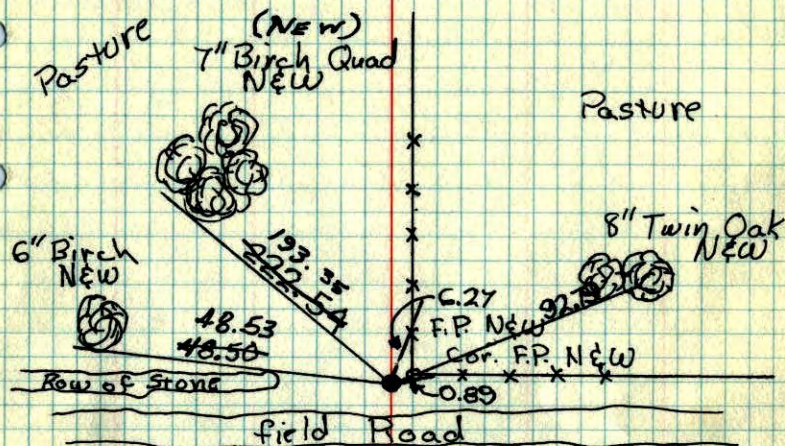

Oct 9, 1963
 J. Oliver
 E. Madson

Tie check
 Aug. 14, 1873
 B. Olson
 D. Brian
 D. Farmer

Field


TIE CHECK	TIE CHECK	TIE CHECK
8-9-82	7-25-79	7-29-76
P. ROSS	B. STEPHENS	C. ADAMS
P. HORNBY	D. STEPHENS	S. BRIEN
	P. ROSS	J. STEPHENS

ROLAND W. ANDERSON
 COUNTY SURVEYOR
 ANOKA COUNTY, MINNESOTA

TEMPERATURE CORRECTED
 AND HORIZONTALLY
 TAPED MEASUREMENTS

S.E. Cor. Sec. 25-33-25

Found 0.4' x 0.6' Field Stone
 Stone fits Old Cartwright ties
 Replaced Stone with 3/4" Iron Pipe.
 7" Birch Quad.
 Nail & Washer

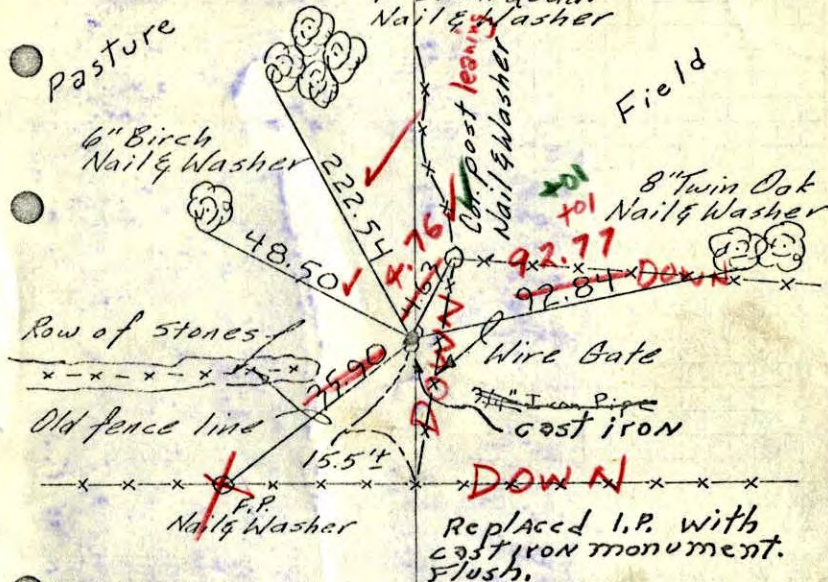

Oct 9, 1963
 J. Oliver
 E. Madson

Field

Tie check
 Aug 25, 1965
 M.D. Anderson
 J. Dunlop

7/25/69
 #5-85
 D. Powell
 R. Olson
 B. Olson

TEMPERATURE CORRECTED
 AND HORIZONTALLY
 TAPED MEASUREMENTS


ROLAND W. ANDERSON
 COUNTY SURVEYOR
 ANOKA COUNTY, MINNESOTA

S.E. Cor. Sec. 25-33-25

Found 0.4' x 0.6' Field Stone

Stone fits Old Cartwright ties

Replaced Stone with 3/4" Iron Pipe,
7" Birch Quad,
Nail & Washer

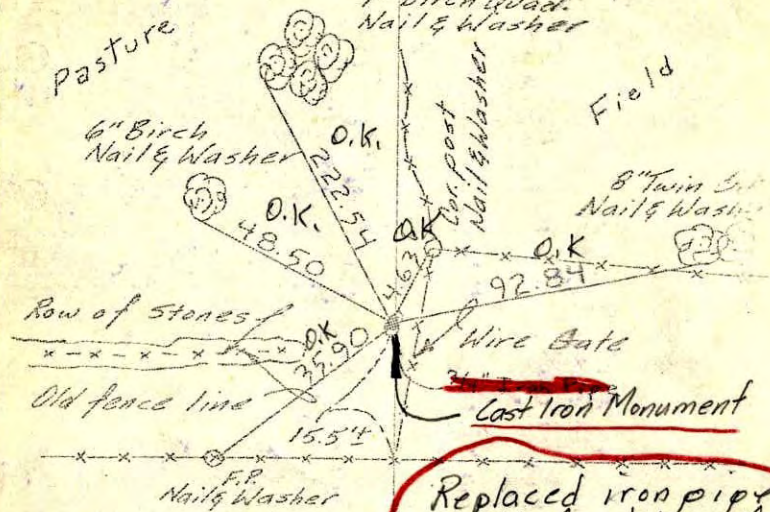

Replaced iron pipe
with Cast Iron Mon.
flash
All ties good

Oct 9, 1963

J. Oliver
E. Madson

tie check

Aug. 26, 1965

M.D. Anderson

J. Dunlop

TEMPERATURE CORRECTED
AND HORIZONTALLY
TAPED MEASUREMENTS

ROLAND W. ANDERSON
COUNTY SURVEYOR
ANOKA COUNTY, MINNESOTA

Entered
HL


Probable SE Cor. Sec. 25, T33, R25

Found 0.4' x 0.6' Field Stone Flush. Fits

Cartwrights 1945 remaining tie tree to a tenth,
and Fits his 3.5' and 15.5' dimensions to fences
good. Found no trace of tree at N30°E. Dug

down, found nothing. Replaced Stone with
3/4" x 18" I.P. down 0.4'. Set up over I.P. -
put 85° in gun-sighted tree, turned to Zero,

which falls 6° W of Magnetic North. Zero°
lines with fence to North.

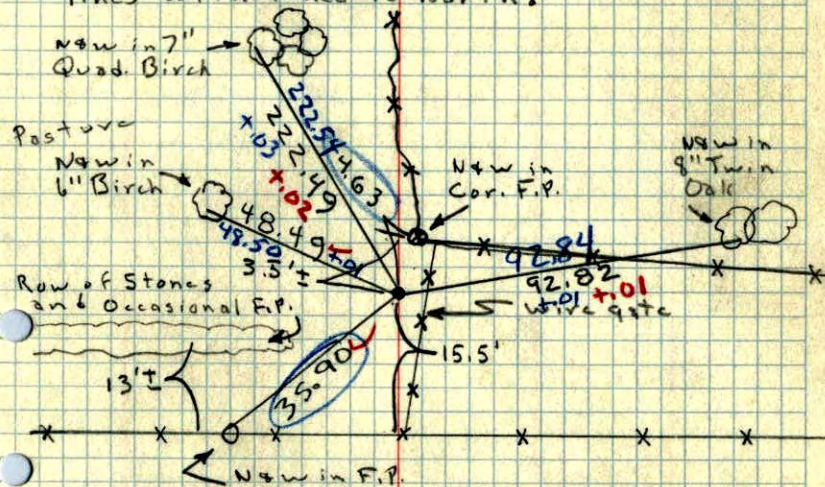


9 Oct 63
80° ± 2

J. Oliver
E. Madson

Ernest Hubbeck?
on #47 & #22 knows
where this one is.

S.E. CORNER OF SEC. 25, T 33, R 25
STONE

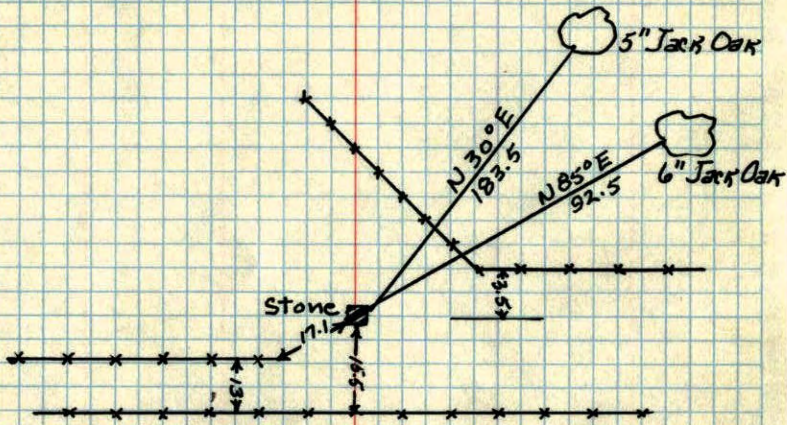

Revised
11 Oct 63
J.O.

Aug 13, 1945
CARTWRIGHT