


Center Sec. 30, T33, R25

Axel Shaft 0.5' Up

JACKSON 11/15/46

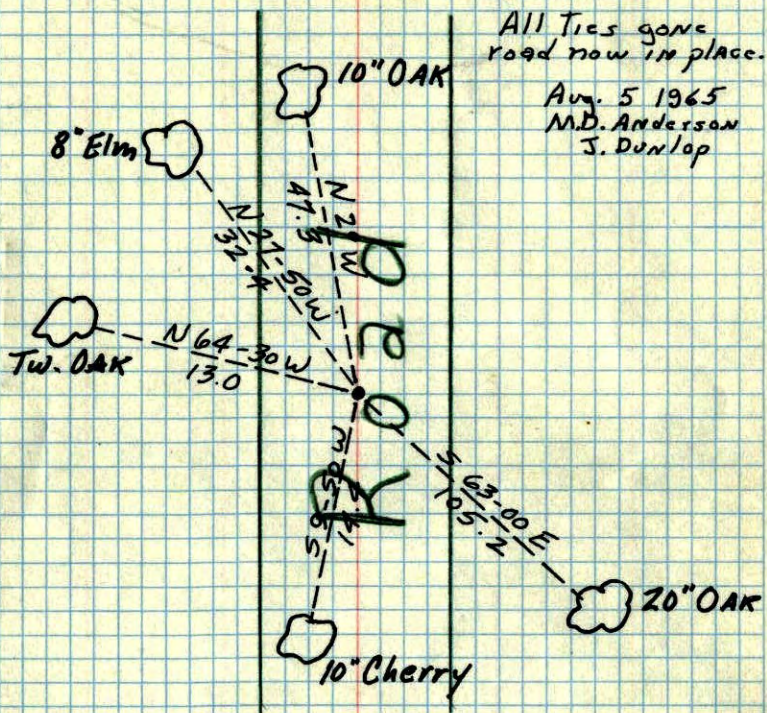

All Ties gone
road now in place.


Aug. 5 1965
M.D. Anderson
J. Dunlop

Taken Out
of Book
8/26/70

Center Sec. 30, T33, R25

Axel Shaft 0.5' Up

JACKSON 11/15/46

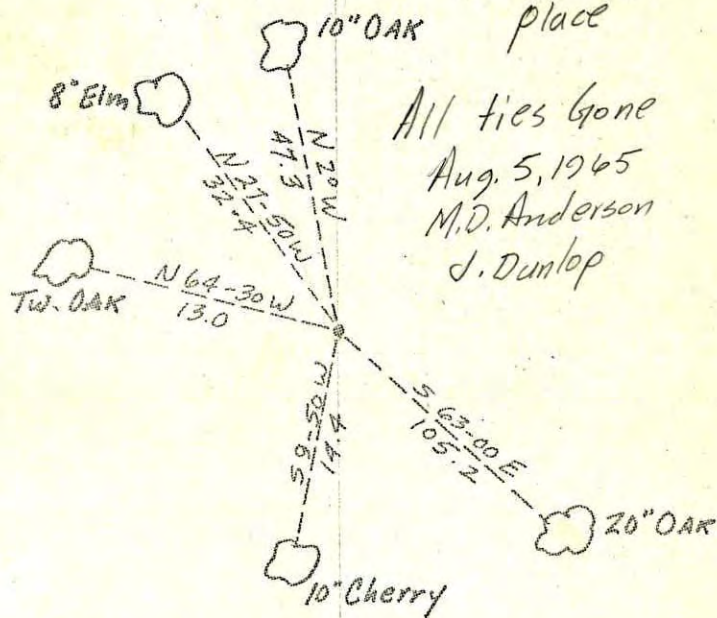

road now in
place

All ties Gone
Aug. 5, 1965
M.D. Anderson
J. Dunlop

Entered
H.L.