


S 1/4 CORNER OF SEC 31, T33, R25

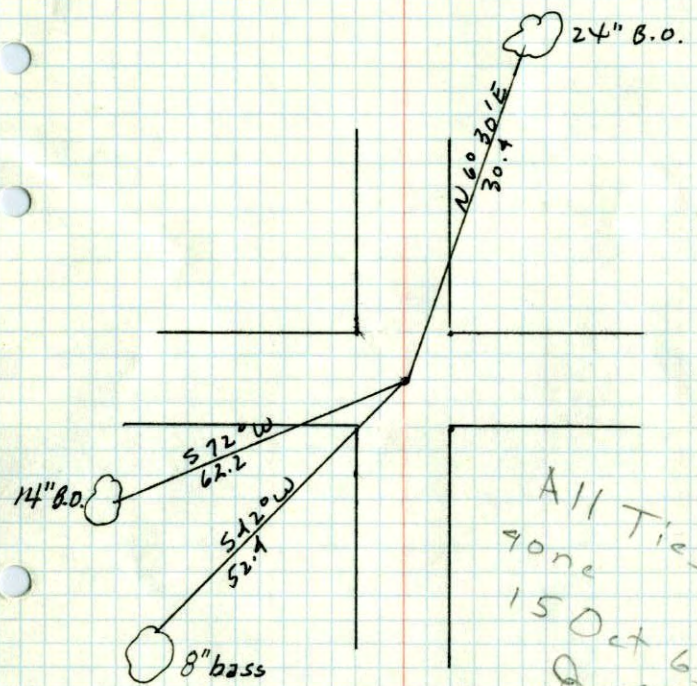

All Ties  
gone  
15 Oct 63  
A.C.

April 17, 1956  
A.C. Hwy. D.

S 1/4 Corn. Sec. 31, 33-25

Hwy. Dept.

