


SE Corn. Sec. 24, 33-25

Hwy. Dept.

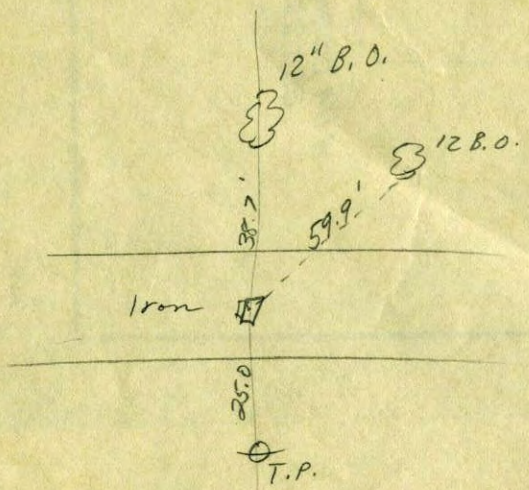

SE sec. 24 T33 R25

