

CERTIFICATE OF LOCATION OF GOVERNMENT CORNER

County of Anoka

State of Minnesota

Witness Corner of Sec. 2 Township 33 Range 25


(on east line of section)

On the 14th day of March, 2001, the described corner was evidenced by area resurvey

and to perpetuate the location of said corner, at the exact location thereof, a permanent marker was placed consisting of a cast iron monument with a sign and post on the north side

AND on the 14th day of July, 2021, said permanent marker was found flush and the ties were updated

Updated reference ties are as shown below.

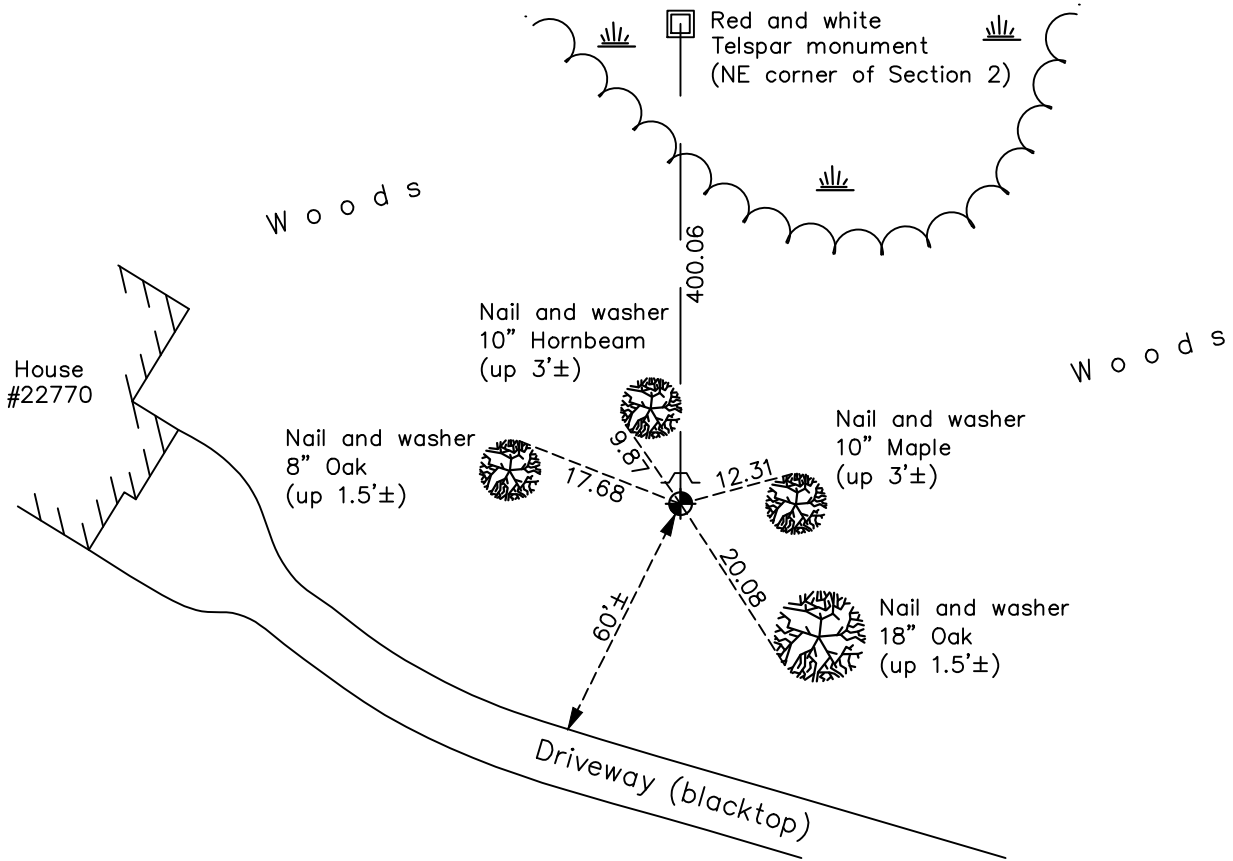

N

 S

Revision Date
7/27/2021

N.A.D. 1983 Coordinates
(1996 Adjustment)

County Project Coordinates	
Northing	<u>227145.8210</u>
Easting	<u>463406.0956</u>
Date	<u>11/01/02</u>

I hereby certify that this United States public land survey monument record is correct and complete to the best of my knowledge and belief.

David Zieglmeier Date 3/28/24

David M. Zieglmeier, Anoka County Surveyor
 Minnesota License Number 46179

HISTORY OF GOVERNMENT CORNER

County of Anoka

State of Minnesota

Witness Corner of Sec. 2 Township 33 Range 25
(on east line of section)

CORNER HISTORY:

March 14, 2001 - Set cast iron witness monument 400 ft. south of red and white iron pipe in swamp using area resurvey. Set sign and post on northwest side. Established ties to monument.

November 1, 2002 - Established NAD 1983 (1996 adj.) Anoka County project coordinates by static GPS methods.

March 27, 2013 - Found cast iron monument and updated ties.

January 17, 2018 - Found cast iron monument flush and updated ties.

July 14, 2021 - Found cast iron monument flush and updated ties.