

CERTIFICATE OF LOCATION OF GOVERNMENT CORNER

County of Anoka

State of Minnesota


North 1/4 Corner of Sec. 3 Township 33 Range 25

On the 18th day of November, 1974, the described corner was evidenced by area resurvey

and to perpetuate the location of said corner, at the exact location thereof, a permanent marker was placed consisting of a cast iron monument with a sign and post on the northwest side

AND on the 7th day of July, 2021, said permanent marker was found flush and the ties were updated

Updated reference ties are as shown below.

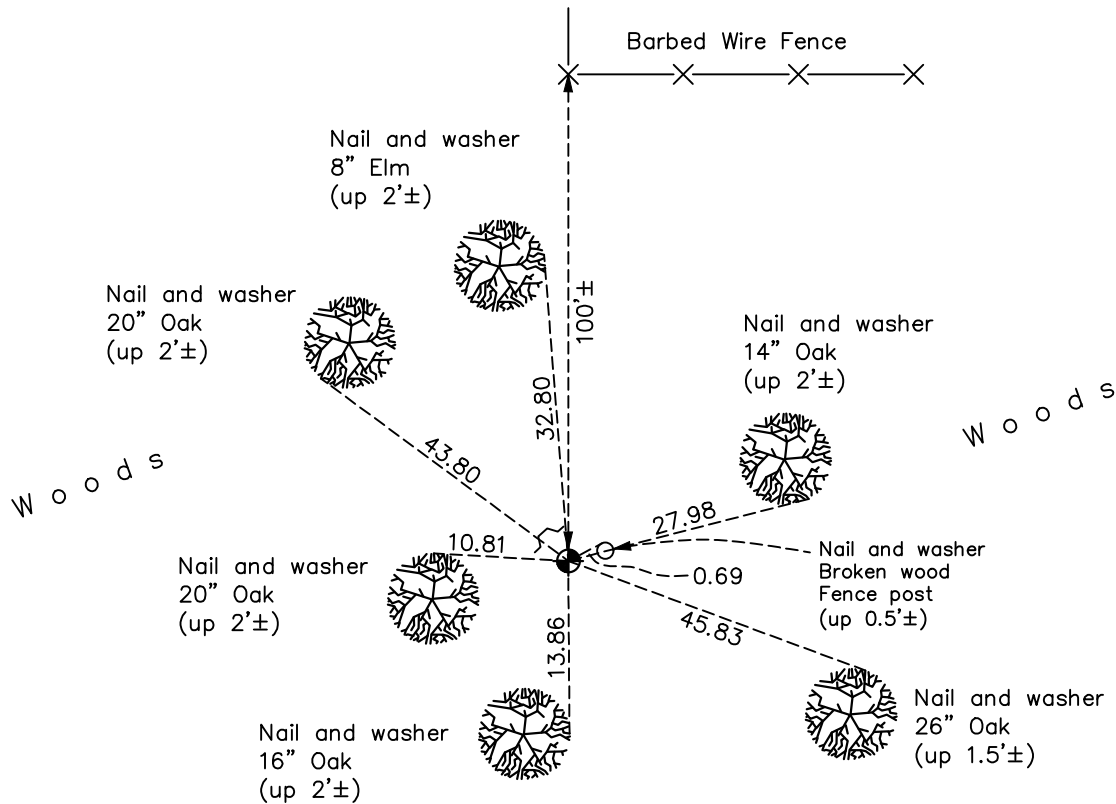

Revision Date
7/27/2021

N.A.D. 1983 Coordinates
 (1996 Adjustment)

County Project Coordinates	
Northing	<u>227605.6284</u>
Easting	<u>455501.0219</u>
Date	<u>12/11/02</u>

I hereby certify that this United States public land survey monument record is correct and complete to the best of my knowledge and belief.

David Zieglmeier Date 3/28/24

David M. Zieglmeier, Anoka County Surveyor
 Minnesota License Number 46179

HISTORY OF GOVERNMENT CORNER

Page No. 6

County of Anoka

State of Minnesota

North 1/4 Corner of Sec. 3 Township 33 Range 25

CORNER HISTORY:

September 1849 - This corner was established by Theodore Conkey, Deputy Surveyor. Conkey marked the position by "set post for quarter section corner" with two bearing trees marked as accessories.

November 18, 1974 - Set cast iron monument using area resurvey. Established ties to monument. Set sign and post on northwest side.

July 14, 1976 - Found cast iron monument and updated ties.

July 24, 1979 - Found cast iron monument and updated ties.

August 5, 1982 - Found cast iron monument and updated ties.

July 15, 1985 - Found cast iron monument and updated ties.

June 16, 1989 - Found cast iron monument and updated ties.

July 11, 1994 - Found cast iron monument and updated ties.

December 11, 2002 - Found cast iron monument and updated ties. Established NAD 1983 (1996 adj.) Anoka County project coordinates by static GPS methods.

April 17, 2013 - Found cast iron monument w/sign missing and updated ties. Set new sign and post on the northwest side (8/1/2014).

February 22, 2018 - Found cast iron monument flush w/sign and post on the northwest side. Verified position by VRS GPS methods. Updated ties.

July 7, 2021 - Found cast iron monument flush w/sign and post on the northwest side. Updated ties.