

CERTIFICATE OF LOCATION OF GOVERNMENT CORNER

County of Anoka

State of Minnesota



West 1/4 Corner of Sec. 4 Township 33 Range 25

On the 19th day of March, 1982, the described corner was evidenced by a 1/2" iron pipe

and to perpetuate the location of said corner, at the exact location thereof, a permanent marker was placed consisting of a cast iron monument with a sign and post on the north side

AND on the 17th day of April, 2013, said permanent marker was replaced with a 2"x8' square steel Telspar monument with a 'County Surveyor' cap. Sign and post 1' north. Ties updated.

Updated reference ties are as shown below.

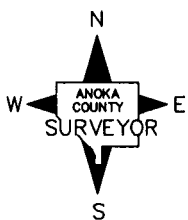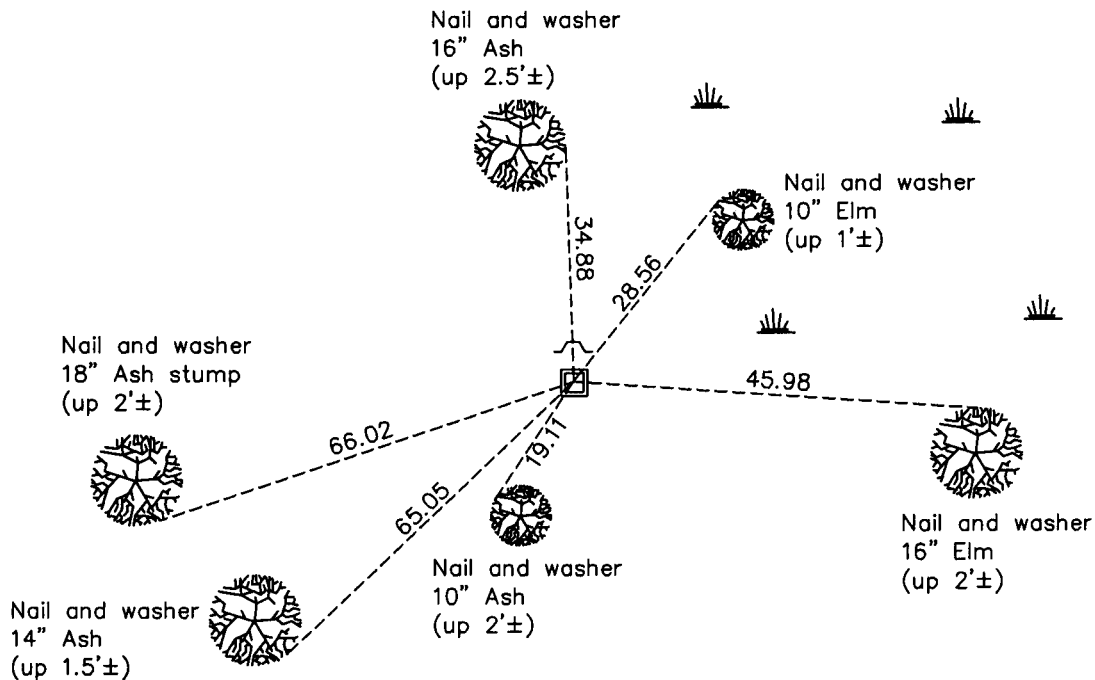

Revision Date
12/24/13

N.A.D. 1983 Coordinates
(1996 Adjustment)

County Project Coordinates	
Northing	<u>225210.0166</u>
Easting	<u>447584.3982</u>
Date	<u>2/04/03</u>

I hereby certify that this United States public land survey monument record is correct and complete to the best of my knowledge and belief.

Date 12/24/13
Larry D. Hoium, Anoka County Surveyor
 Minnesota License Number 18165