

# CERTIFICATE OF LOCATION OF GOVERNMENT CORNER

County of Anoka

State of Minnesota



Witness Corner of Sec. 1 Township 33 Range 25  
 (On south line of section)

On the 16th day of June, 1967, the described corner was evidenced by area resurvey

and to perpetuate the location of said corner, at the exact location thereof, a permanent marker was placed consisting of a cast iron monument with a sign and post on the south side

AND on the 4th day of September, 2014, said permanent marker was found and the ties were updated

Updated reference ties are as shown below.

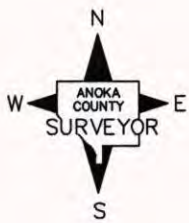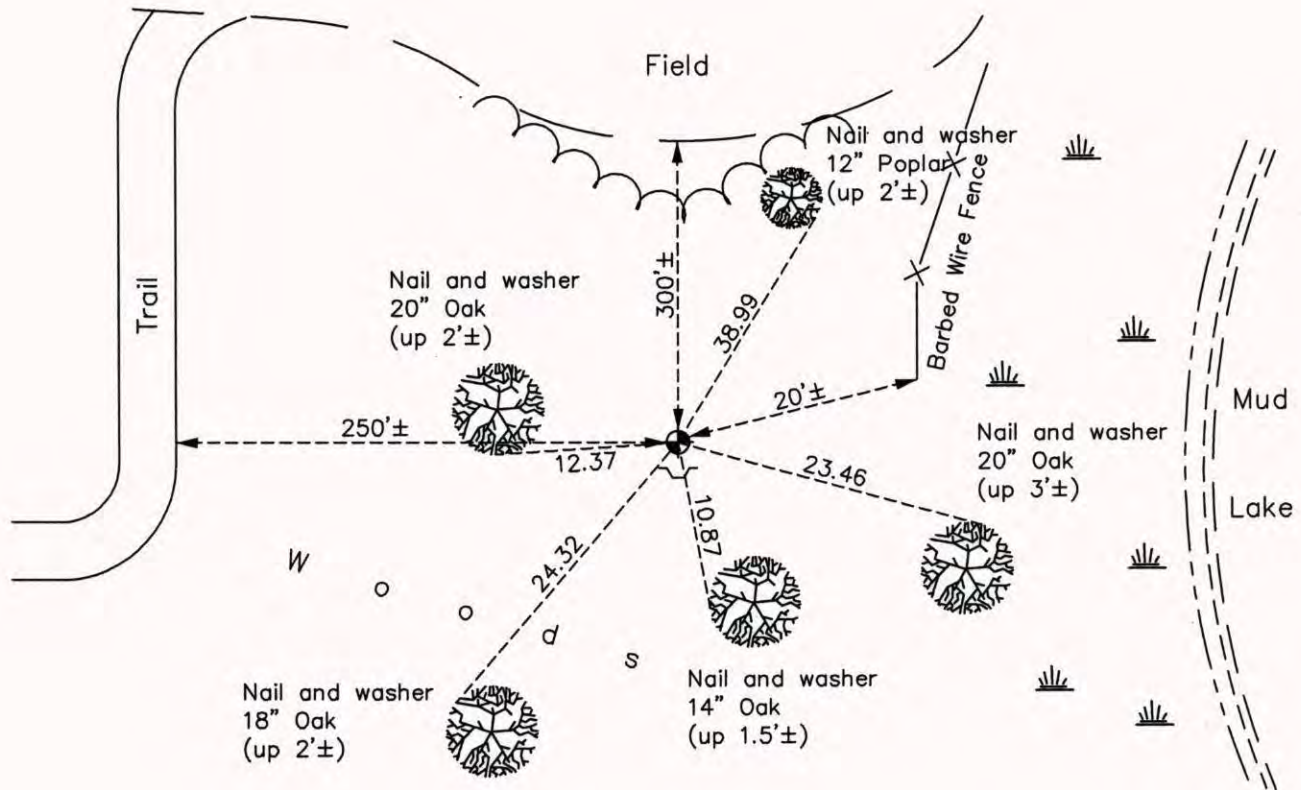

Revision Date  
10/20/14

N.A.D. 1983 Coordinates  
 (1996 Adjustment)

County Project Coordinates	
Northing	222406.5908
Easting	466907.7883
Date	11/05/02

I hereby certify that this United States public land survey monument record is correct and complete to the best of my knowledge and belief.

*Larry D. Hoium* Date 10/20/14

Larry D. Hoium, Anoka County Surveyor  
 Minnesota License Number 18165