

CERTIFICATE OF LOCATION OF GOVERNMENT CORNER

County of Anoka

State of Minnesota



South $\frac{1}{4}$ Corner of Sec. 1 Township 33 Range 25

On the 28th day of December, 1977, the described corner was evidenced by area resurvey

and to perpetuate the location of said corner, at the exact location thereof, a permanent marker was placed consisting of a red and white 2" iron pipe

AND on the 28th day of October, 2013, said permanent marker was found with paint worn off and a sign attached facing south. The ties were updated.

Updated reference ties are as shown below.

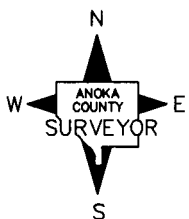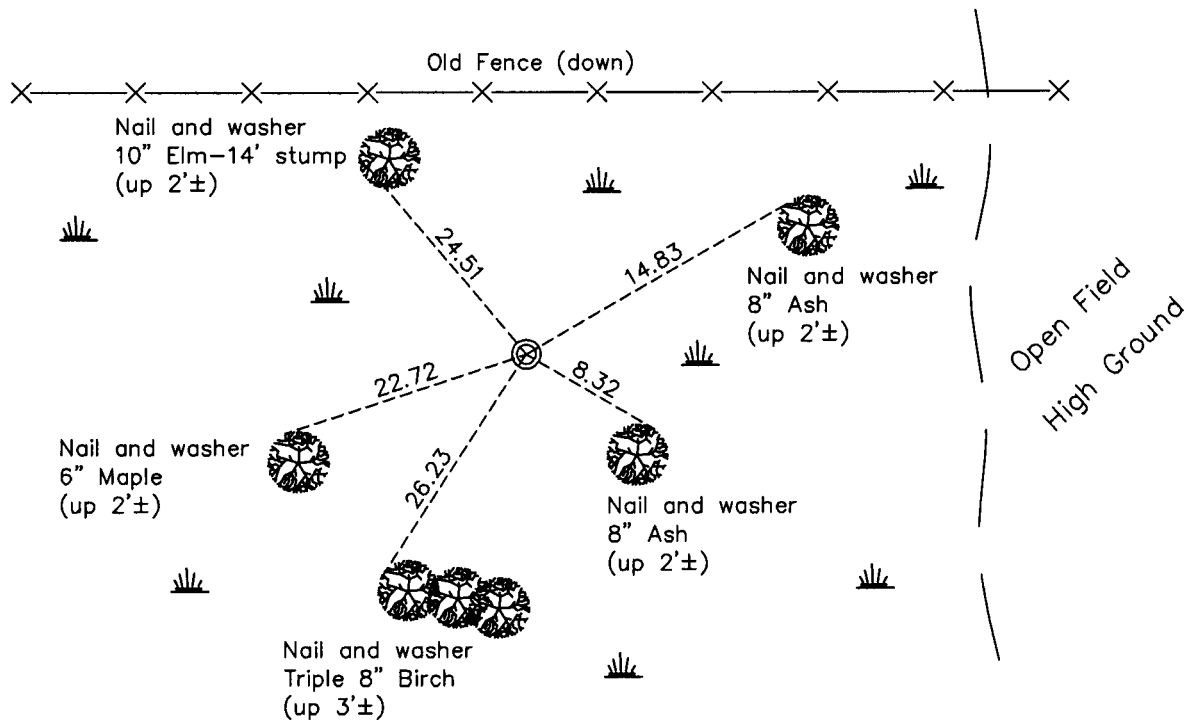

Revision Date
12/27/13

N.A.D. 1983 Coordinates
(1996 Adjustment)

County Project Coordinates	
Northing	222398.4509
Easting	466018.3679
Date	11/05/02

I hereby certify that this United States public land survey monument record is correct and complete to the best of my knowledge and belief.

Larry D. Hoium Date 12/27/13

Larry D. Hoium, Anoka County Surveyor
Minnesota License Number 18165