

CERTIFICATE OF LOCATION OF GOVERNMENT CORNER

County of Anoka

State of Minnesota



West 1/4 Corner of Sec. 10 Township 33 Range 25

On the 27th day of December, 1974, the described corner was evidenced by area resurvey

and to perpetuate the location of said corner, at the exact location thereof, a permanent marker was placed consisting of a 1 1/2" red and white iron pipe

AND on the 20th day of March, 2013, said permanent marker was found and the ties were updated

Updated reference ties are as shown below.

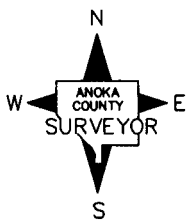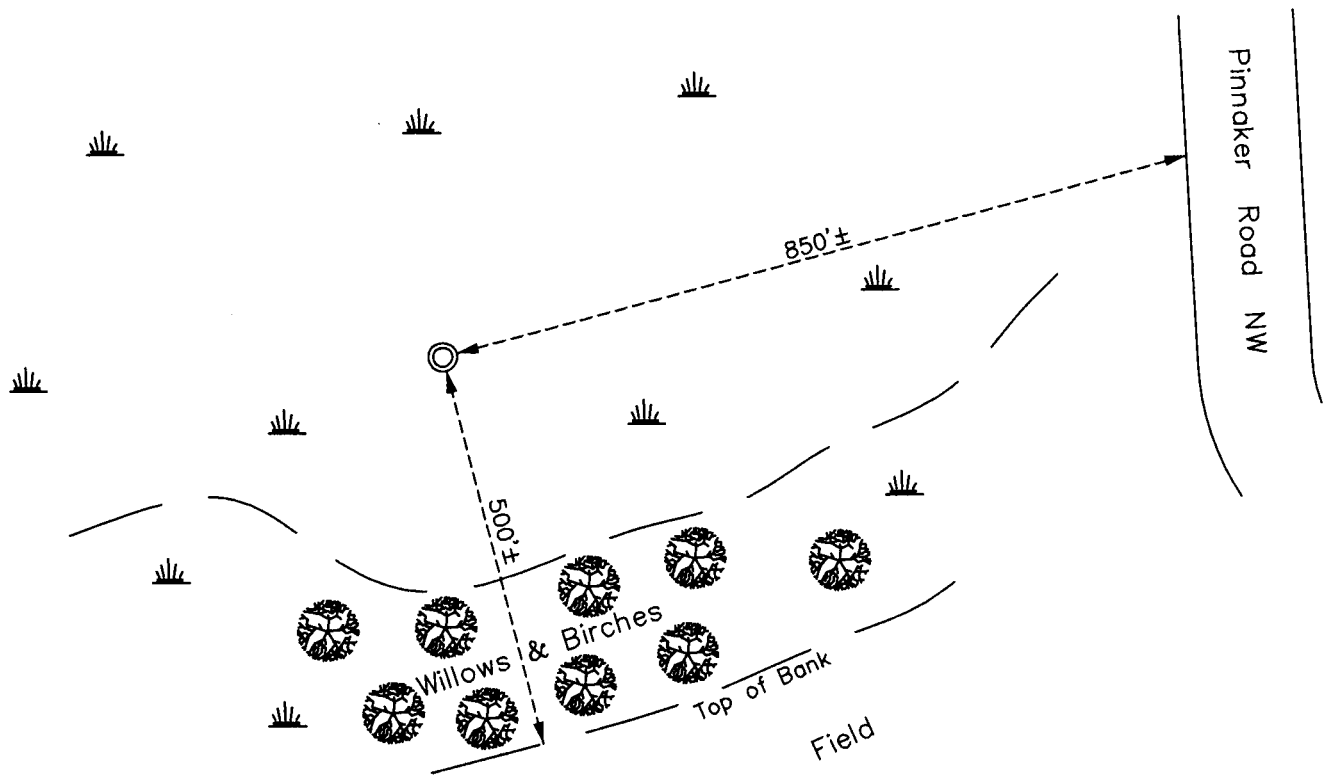

Revision Date
 1/08/14

N.A.D. 1983 Coordinates
 (1996 Adjustment)

County Project Coordinates	
Northing	219892.0864
Easting	452880.2299
Date	12/11/02

I hereby certify that this United States public land survey monument record is correct and complete to the best of my knowledge and belief.

Larry D. Hoium Date 1/08/14

Larry D. Hoium, Anoka County Surveyor
 Minnesota License Number 18165