

CERTIFICATE OF LOCATION OF GOVERNMENT CORNER

County of Anoka

State of Minnesota


North 1/4 Corner of Sec. 14 Township 33 Range 25

On the 15th day of December, 1972, the described corner was evidenced by area resurvey

and to perpetuate the location of said corner, at the exact location thereof, a permanent marker was placed consisting of a cast iron monument with a sign and post on the south side

AND on the 29th day of March, 2018, said permanent marker was found flush and the ties were updated

Updated reference ties are as shown below.

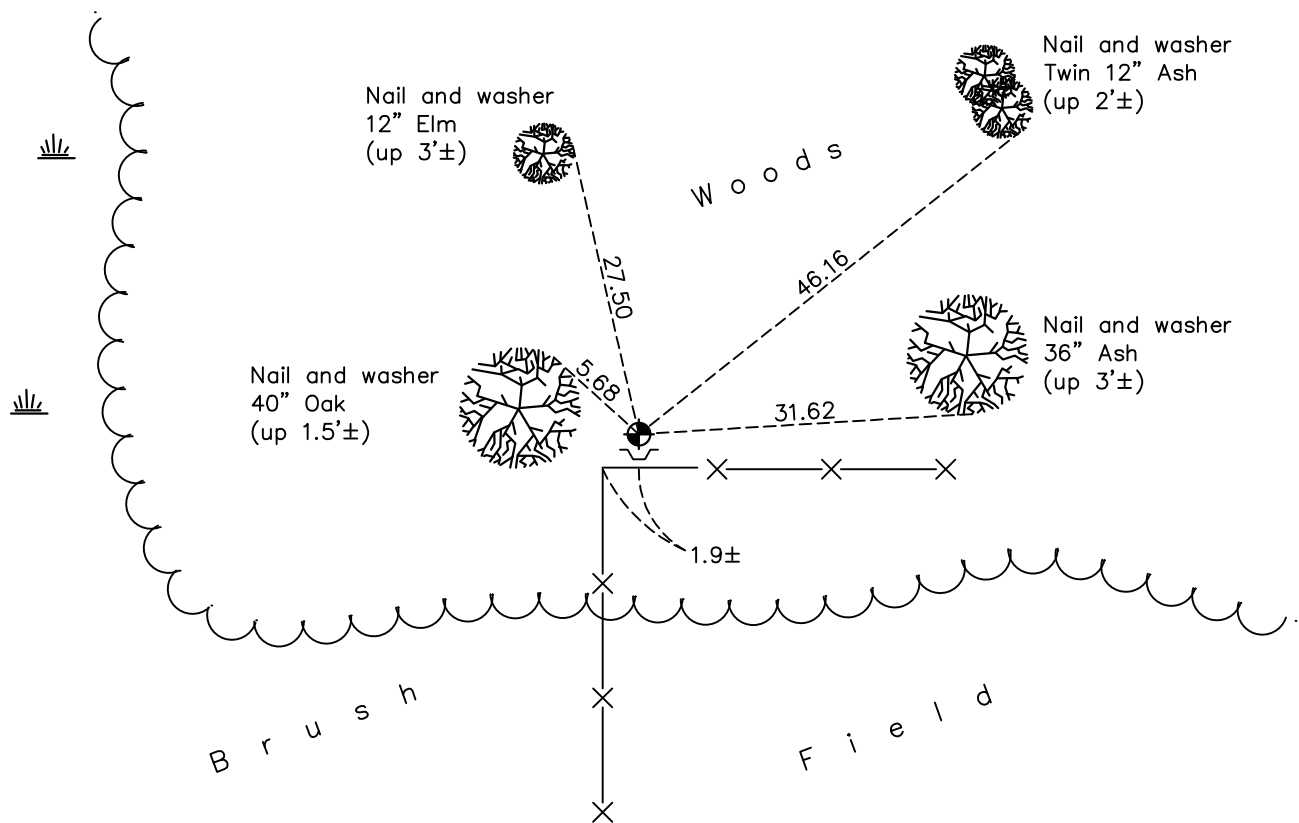

Revision Date

4/15/18

N.A.D. 1983 Coordinates
(1996 Adjustment)

County Project Coordinates	
Northing	<u>217182.6497</u>
Easting	<u>460774.0629</u>
Date	<u>10/10/02</u>

I hereby certify that this United States public land survey monument record is correct and complete to the best of my knowledge and belief.

David M. Zieglmeier Date 6/9/21

David M. Zieglmeier, Anoka County Surveyor

Minnesota License Number 46179

HISTORY OF GOVERNMENT CORNER

Page No. 42

County of Anoka

State of Minnesota

North 1/4 Corner of Sec. 14 Township 33 Range 25

CORNER HISTORY:

May 1855 - This corner was established by James M. Marsh, Deputy Surveyor. Marsh marked the position by "set quarter section post" with one bearing tree marked as an accessory.

December 15, 1972 - Set 1/2" iron pipe using area resurvey. Established ties to iron pipe.

July 30, 1973 - Set cast iron monument and updated ties.

July 19, 1976 - Found cast iron monument and updated ties.

July 18, 1979 - Found cast iron monument and updated ties.

August 5, 1982 - Found cast iron monument and updated ties.

July 11, 1985 - Found cast iron monument and updated ties.

June 19, 1989 - Found cast iron monument and updated ties.

July 15, 1994 - Found cast iron monument and updated ties.

October 8, 2002 - Found cast iron monument and updated ties.

October 10, 2002 - Established NAD 1983 (1996 adj.) Anoka County project coordinates by static GPS methods.

March 20, 2013 - Found cast iron monument and updated ties.

March 29, 2018 - Found cast iron monument flush and updated ties.