

CERTIFICATE OF LOCATION OF GOVERNMENT CORNER

County of Anoka

State of Minnesota


North $\frac{1}{4}$ Corner of Sec. 17 Township 33 Range 25

On the 14th day of March, 1974, the described corner was evidenced by a red and white iron pipe set by N.C. Hoium

and to perpetuate the location of said corner, at the exact location thereof, a permanent marker was placed consisting of a 2"x2"x7' steel Telspar monument with punch marked cap

AND on the 13th day of November, 2013, said permanent marker was Replaced red & white iron w/2" sq. steel Telspar monument w/punchmarked cap up 3'± using static GPS methods. Updated ties.

Updated reference ties are as shown below.

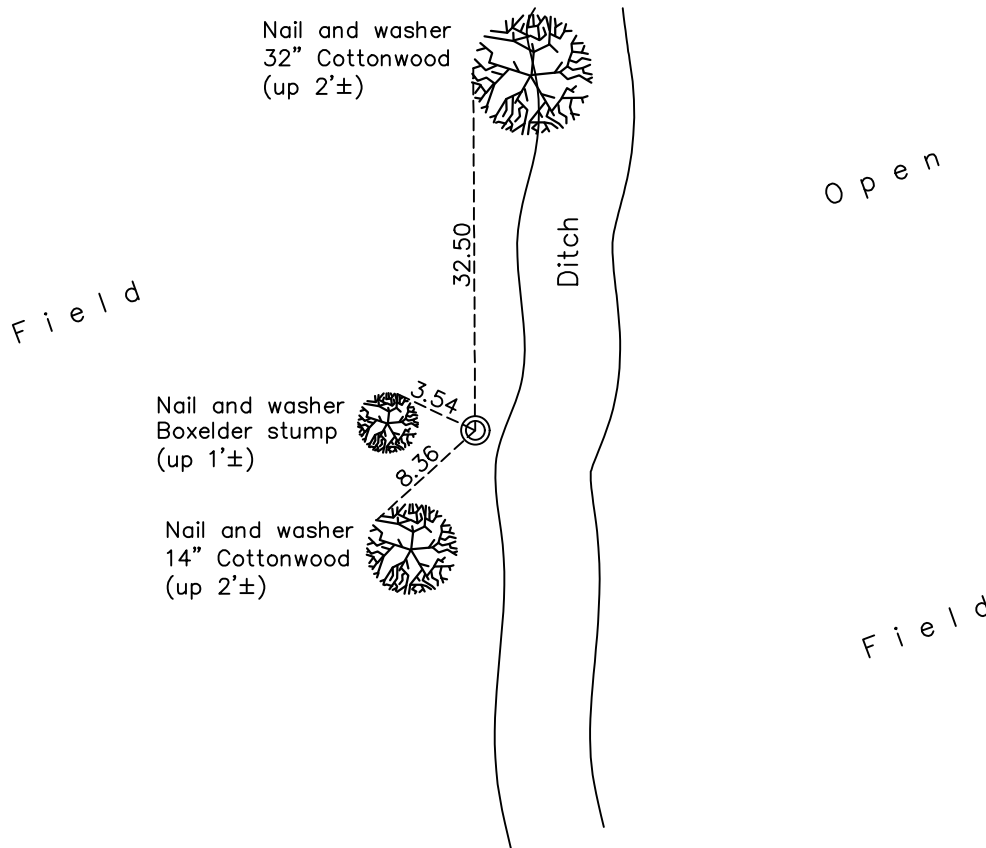

Revision Date

6/4/21

N.A.D. 1983 Coordinates
(1996 Adjustment)

County Project Coordinates	
Northing	<u>217360.5003</u>
Easting	<u>444936.2010</u>
Date	<u>1/29/03</u>

I hereby certify that this United States public land survey monument record is correct and complete to the best of my knowledge and belief.

David M. Zieglmeier Date 6/9/21

David M. Zieglmeier, Anoka County Surveyor

Minnesota License Number 46179

HISTORY OF GOVERNMENT CORNER

Page No. 48

County of Anoka

State of Minnesota

North 1/4 Corner of Sec. 17 Township 33 Range 25

CORNER HISTORY:

May 1855 - This corner was established by James M. Marsh, Deputy Surveyor. Marsh marked the position by "set quarter section post" with one bearing tree marked as an accessory.

March 14, 1974 - Found 2" red and white iron pipe up 4'± set by N.C. Hoium. Updated the ties.

July 22, 1976 - Found red and white iron pipe and updated ties.

July 19, 1979 - Found red and white iron pipe and updated ties.

August 4, 1982 - Found red and white iron pipe and updated ties.

July 8, 1985 - Found red and white iron pipe and updated ties.

June 21, 1989 - Found red and white iron pipe and updated ties.

January 29, 2003 - Found red and white iron pipe and updated ties. Established NAD 1983 (1996 adj.) Anoka County project coordinates by static GPS methods.

November 13, 2013 - Found red and white iron pipe up 3'± and leaning easterly. Updated ties.

February 15, 2019 - Found red and white iron pipe up 3'± and leaning easterly. Checked position at base with VRS GPS methods and corner ties. Needs reset.

June 18, 2019 - Replaced red and white iron pipe with a 2"x2"x7' steel Telspar monument w/punch marked cap up 3'± and sign attached using static GPS methods. Updated ties.