

CERTIFICATE OF LOCATION OF GOVERNMENT CORNER

County of Anoka

State of Minnesota


Northwest Corner of Sec. 17 Township 33 Range 25

On the 14th day of March, 1974, the described corner was evidenced by a 2" red and white iron pipe set by N.C. Hoium

and to perpetuate the location of said corner, at the exact location thereof, a permanent marker was placed consisting of a 2" square steel Telspar monument with sign attached

AND on the 23rd day of March, 2018, said permanent marker was found up 5'± and the position was verified by VRS GPS methods. Unable to update ties.

Updated reference ties are as shown below.

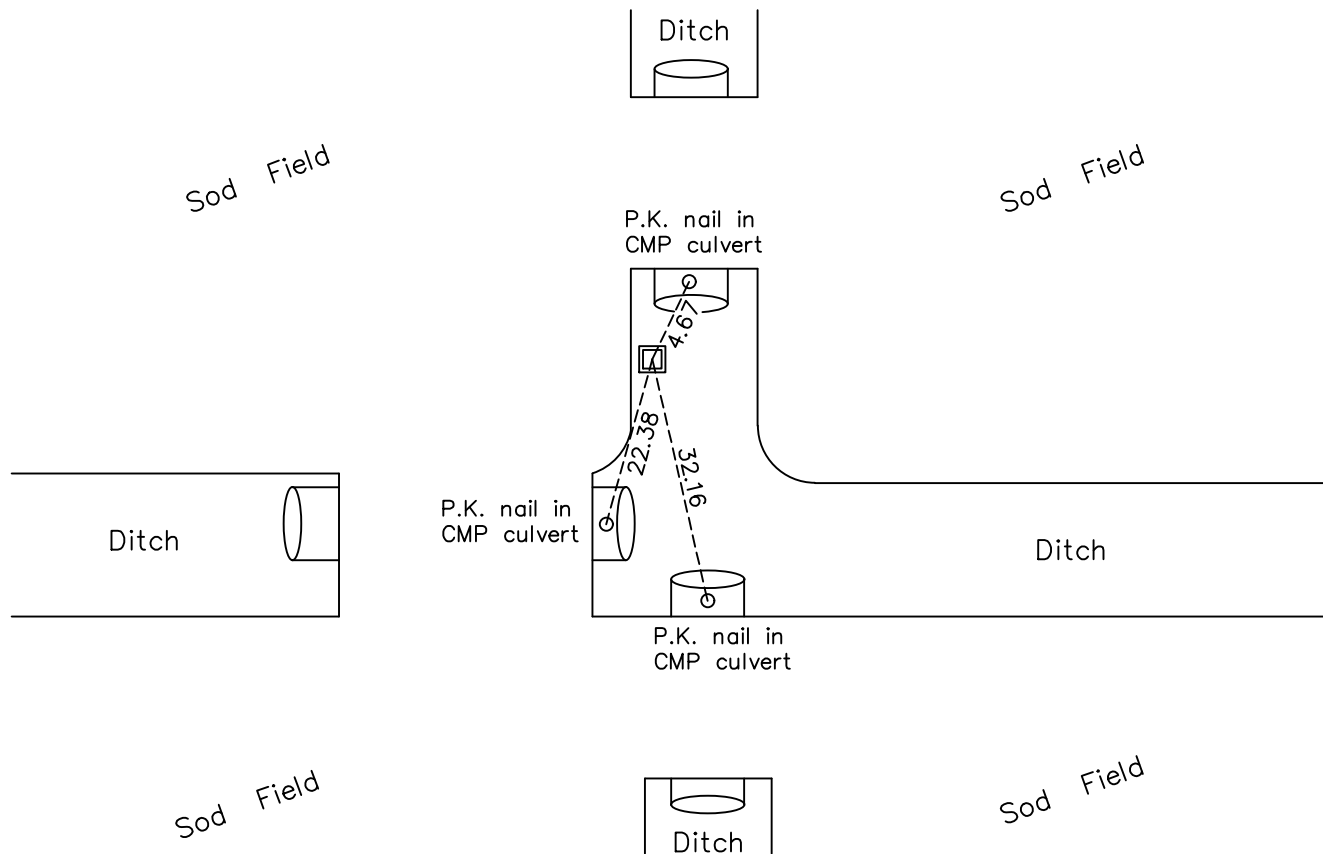

Revision Date

4/16/18

N.A.D. 1983 Coordinates
(1996 Adjustment)

County Project Coordinates	
Northing	<u>217405.8544</u>
Easting	<u>442302.1776</u>
Date	<u>2/26/03</u>

I hereby certify that this United States public land survey monument record is correct and complete to the best of my knowledge and belief.

David M. Zieglmeier Date 6/9/21

David M. Zieglmeier, Anoka County Surveyor

Minnesota License Number 46179

HISTORY OF GOVERNMENT CORNER

Page No. 49

County of Anoka

State of Minnesota

Northwest Corner of Sec. 17 Township 33 Range 25

CORNER HISTORY:

May 1855 - This corner was established by James M. Marsh, Deputy Surveyor. Marsh marked the position by "set post corner of sections 7, 8, 17 and 18" with one bearing tree marked as an accessory.

March 14, 1974 - Found 2" red and white iron pipe up 4'± set by N.C. Hoium. Updated ties.

July 22, 1976 - Found 2" red and white iron pipe and updated ties.

March 18, 1980 - Found red and white iron pipe up 4'± and 20'± north of east/west ditch. Updated ties.

August 4, 1982 - Found red and white iron pipe and updated ties.

October 25, 1985 - Found red and white iron pipe and updated ties.

July 13, 1994 - Found red and white iron pipe and updated ties.

February 26, 2003 - Established NAD 1983 (1996 adj.) Anoka County project coordinates by static GPS methods.

March 20, 2013 - Found 2" x 2" steel Telspar up 5'± w/sign attached. Verified position by VRS GPS methods. Ties not updated due to snow covering culverts.

August 5, 2013 - Found 2" x 2" steel Telspar up 5'± w/sign attached. Updated ties.

March 23, 2018 - Found 2" x 2" steel Telspar up 5'±. w/sign attached. Verified position by VRS GPS methods. Unable to update ties culverts under ice.