

CERTIFICATE OF LOCATION OF GOVERNMENT CORNER

County of Anoka

State of Minnesota


East 1/4 Corner of Sec. 17 Township 33 Range 25

On the 25th day of July, 1973, the described corner was evidenced by a 1/2" iron pipe

and to perpetuate the location of said corner, at the exact location thereof, a permanent marker was placed consisting of a cast iron monument

AND on the 16th day of January, 2018, said permanent marker was found on centerline and the ties were updated

Updated reference ties are as shown below.

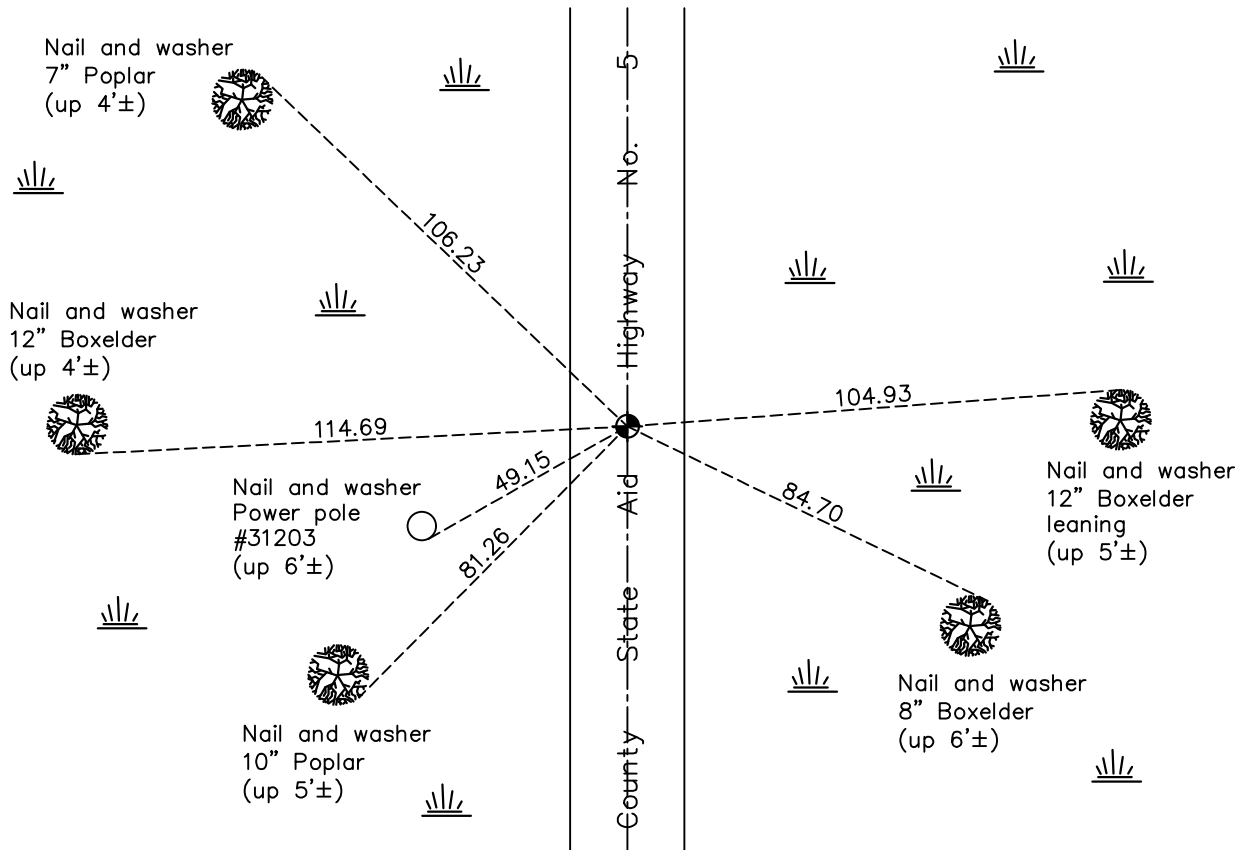

Revision Date

4/17/18

N.A.D. 1983 Coordinates
(1996 Adjustment)

County Project Coordinates	
Northing	<u>214689.5688</u>
Easting	<u>447572.1355</u>
Date	<u>8/21/02</u>

I hereby certify that this United States public land survey monument record is correct and complete to the best of my knowledge and belief.

David M Zieglmeier Date 6/9/21

David M. Zieglmeier, Anoka County Surveyor

Minnesota License Number 46179

HISTORY OF GOVERNMENT CORNER

Page No. 54

County of Anoka

State of Minnesota

East 1/4 Corner of Sec. 17 Township 33 Range 25

CORNER HISTORY:

May 1855 - This corner was established by James M. Marsh, Deputy Surveyor. Marsh marked the position by "set quarter section post" with one bearing tree marked as an accessory.

July 25, 1973 - Replaced 1/2" iron pipe with a cast iron monument and updated ties.

July 22, 1976 - Found cast iron monument and updated ties.

July 11, 1979 - Found cast iron monument and updated ties.

August 5, 1982 - Found cast iron monument and updated ties.

July 2, 1985 - Found cast iron monument and updated ties.

August 25, 1988 - Found cast iron monument and updated ties.

June 27, 1994 - Found cast iron monument and updated ties.

April 18, 1997 - Found cast iron monument and set construction ties prior to construction.

November 3, 1998 - Set cast iron monument after construction. Updated ties.

August 21, 2002 - Established NAD 1983 (1996 adj.) Anoka County project coordinates by static GPS methods.

September 24, 2002 - Found cast iron monument and updated ties.

October 11, 2013 - Found cast iron monument on centerline. Verified position by VRS GPS methods. Updated ties.

January 16, 2018 - Found cast iron monument. Verified position by VRS GPS methods. Updated ties.