

# CERTIFICATE OF LOCATION OF GOVERNMENT CORNER

County of Anoka

State of Minnesota


## North 1/4 Corner of Sec. 24 Township 33 Range 25

On the 21st day of August, 1964, the described corner was evidenced by a 1 1/4" iron pipe used by Leroy Winner

and to perpetuate the location of said corner, at the exact location thereof, a permanent marker was placed consisting of a cast iron monument

AND on the 17th day of January, 2018, said permanent marker was found 2" square steel Telspar monument w/'County Surveyor' cap and sign & post on west side. Updated ties.

Updated reference ties are as shown below.

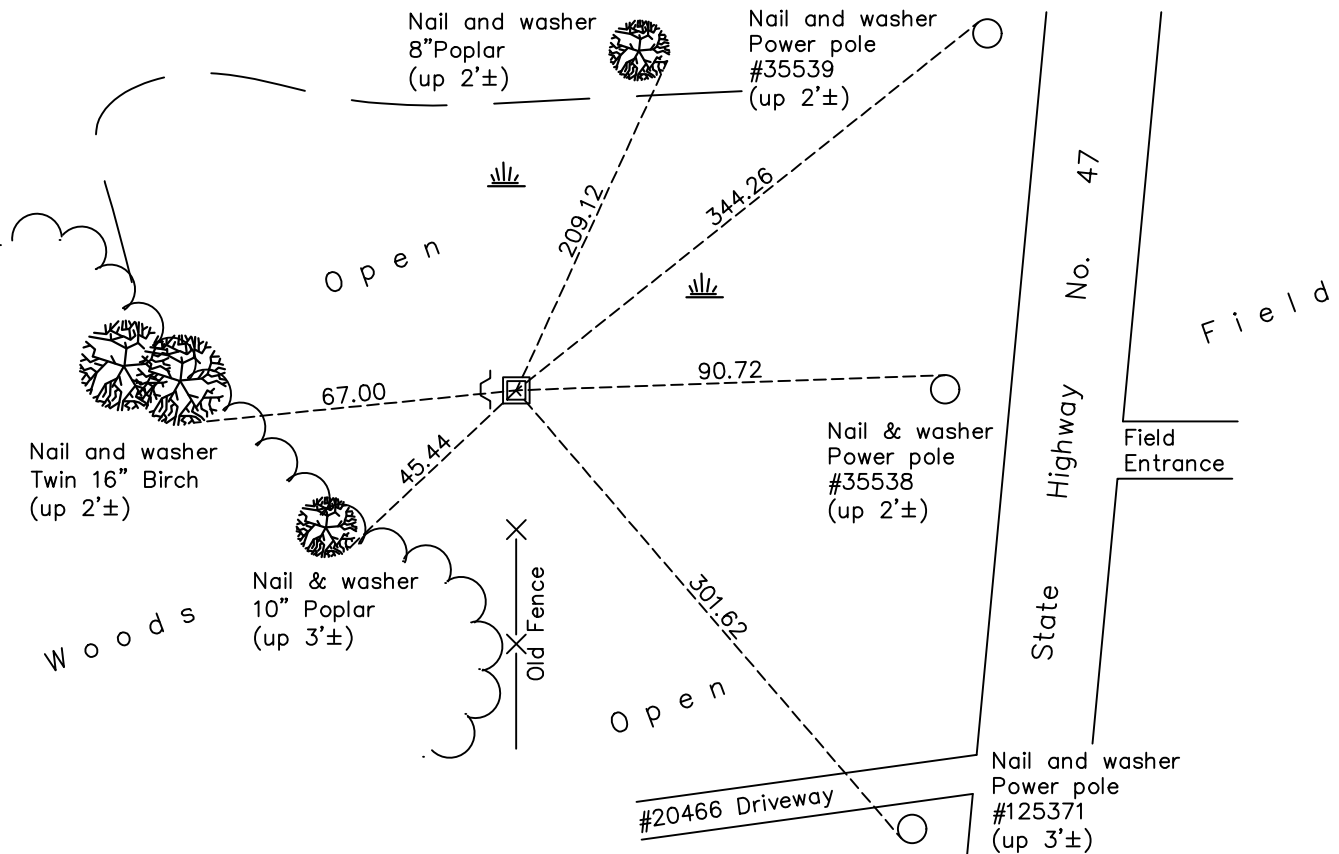

Revision Date

4/17/18

N.A.D. 1983 Coordinates  
(1996 Adjustment)

County Project Coordinates	
Northing	211911.6184
Easting	466002.1606
Date	2/11/03

I hereby certify that this United States public land survey monument record is correct and complete to the best of my knowledge and belief.

*David M. Zieglmeier* Date 6/9/21

David M. Zieglmeier, Anoka County Surveyor

Minnesota License Number 46179

# HISTORY OF GOVERNMENT CORNER

Page No. 59

County of Anoka

State of Minnesota

## North 1/4 Corner of Sec. 24 Township 33 Range 25

### **CORNER HISTORY:**

May 1855 - This corner was established by James M. Marsh, Deputy Surveyor. Marsh marked the position by "set quarter section post" with two bearing trees marked as accessories.

March 7, 1964 - Leroy Winner found 1-1/4" iron pipe up 0.5'± and updated ties.

August 21, 1964 - Found 1-1/4" iron pipe up 0.5'± used by Leroy Winner. Updated ties.

August 16, 1965 - Found 1-1/4" iron pipe and updated ties.

July 16, 1969 - Replaced 1-1/4" iron pipe with cast iron monument up 0.2'±. Updated ties. Set sign and post on the north side.

August 1, 1973 - Found cast iron monument and updated ties.

July 23, 1976 - Found cast iron monument and updated ties.

July 16, 1979 - Found cast iron monument and updated ties.

August 5, 1982 - Found cast iron monument and updated ties.

July 1, 1985 - Found cast iron monument and updated ties.

September 2, 1988 - Found cast iron monument and updated ties.

July 20, 1994 - Found cast iron monument and updated ties.

February 11, 2003 - Established NAD 1983 (1996 adj.) Anoka County project coordinates by static GPS methods.

November 12, 2013 - Found cast iron monument with top broken off. Checked corner ties to center fin. Checked position by VRS GPS methods.

December 2, 2013 - Removed broken cast iron monument and set 2" x 2" x 4' steel Telspar monument w/punch marked cap. Verified position by VRS GPS methods. Updated ties. Set sign and post on the west side.

January 17, 2018 - Found 2" x 2" steel Telspar monument w/cap. Verified position by VRS GPS methods. Updated ties.