

# CERTIFICATE OF LOCATION OF GOVERNMENT CORNER

County of Anoka

State of Minnesota


## North 1/4 Corner of Sec. 22 Township 33 Range 25

On the 18th day of July, 1969, the described corner was evidenced by a 1 1/4" iron pipe set by N.C. Hoium

and to perpetuate the location of said corner, at the exact location thereof, a permanent marker was placed consisting of a cast iron monument with a sign and post on the north side

AND on the 22nd day of March, 2013, said permanent marker was found and the ties were updated

Updated reference ties are as shown below.

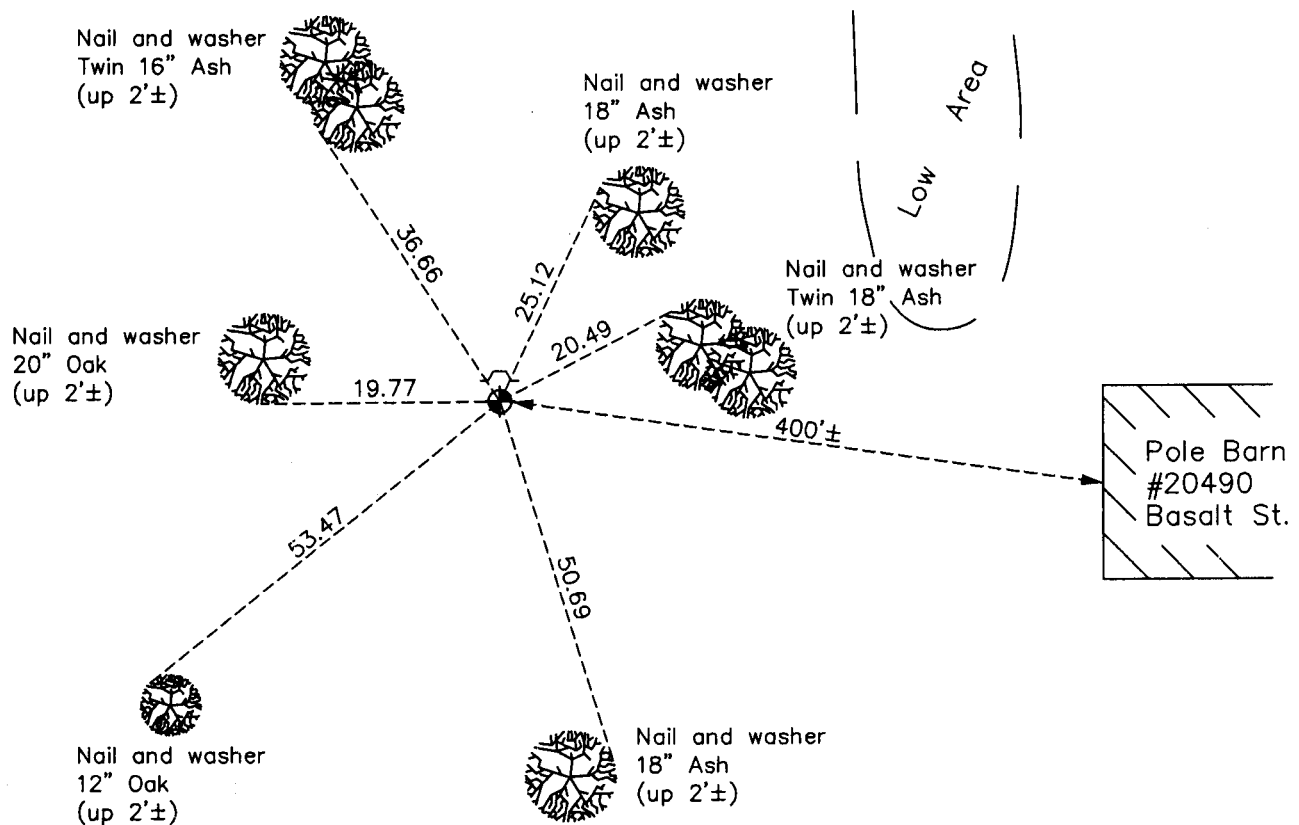

N

S

W      E

Revision Date

1/29/14

N.A.D. 1983 Coordinates  
(1996 Adjustment)

County Project Coordinates	
Northing	211991.7911
Easting	455493.1361
Date	2/13/03

I hereby certify that this United States public land survey monument record is correct and complete to the best of my knowledge and belief.

Date 1/29/14

Larry D. Hoium, Anoka County Surveyor  
 Minnesota License Number 18165