

CERTIFICATE OF LOCATION OF GOVERNMENT CORNER

County of Anoka

State of Minnesota


West 1/4 Corner of Sec. 24 Township 33 Range 25

On the 24th day of August, 1964, the described corner was evidenced by an iron pipe set by Leroy Winner

and to perpetuate the location of said corner, at the exact location thereof, a permanent marker was placed consisting of a cast iron monument

AND on the 6th day of March, 2018, said permanent marker was found flush and the ties were updated

Updated reference ties are as shown below.

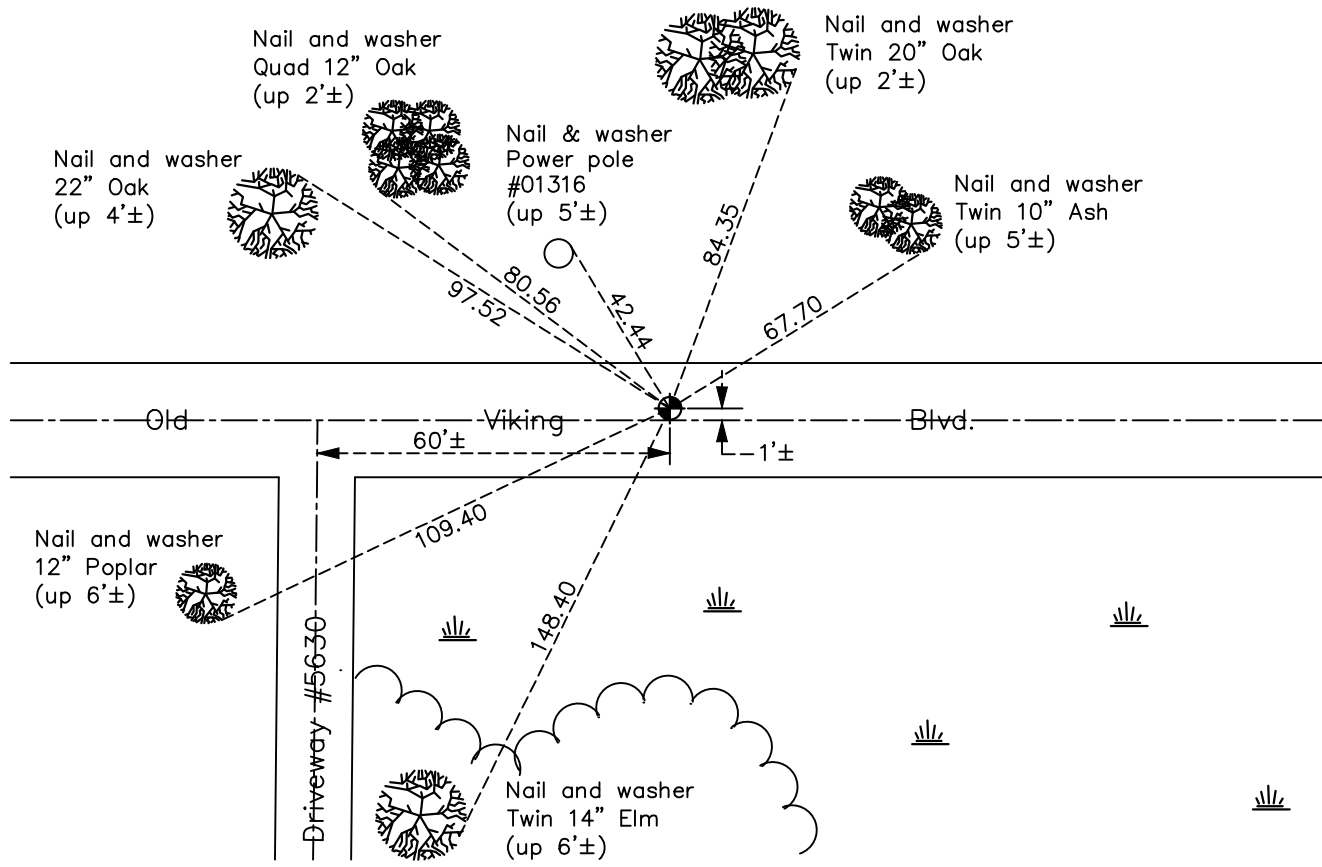

N

S

Revision Date

4/20/18

N.A.D. 1983 Coordinates
(1996 Adjustment)

County Project Coordinates	
Northing	209306.6550
Easting	463381.4216
Date	9/25/02

I hereby certify that this United States public land survey monument record is correct and complete to the best of my knowledge and belief.

David M. Zieglermeier Date 6/9/21

David M. Zieglermeier, Anoka County Surveyor

Minnesota License Number 46179

HISTORY OF GOVERNMENT CORNER

Page No. 76

County of Anoka

State of Minnesota

West 1/4 Corner of Sec. 24 Township 33 Range 25

CORNER HISTORY:

May 1855 - This corner was established by James M. Marsh, Deputy Surveyor. Marsh marked the position by "set quarter section post" with two bearing trees marked as accessories.

March 7, 1964 - Leroy Winner set a 3/4" iron pipe down 0.2'± and established ties to iron pipe.

August 21, 1964 - Found 3/4" iron pipe down 0.2'± set by Leroy Winner. Updated ties.

August 6, 1965 - Found 3/4" iron pipe and updated ties.

July 22, 1969 - Replaced 3/4" iron pipe with a cast iron monument flush. Updated ties.

July 23, 1973 - Found cast iron monument and updated ties.

July 26, 1976 - Found cast iron monument and updated ties.

July 11, 1979 - Found cast iron monument and updated ties.

August 2, 1982 - Found cast iron monument and updated ties.

June 26, 1985 - Found cast iron monument and updated ties.

June 30, 1989 - Found cast iron monument and updated ties.

May 22, 1992 - Found cast iron monument down and raised flush. Updated ties.

July 5, 1994 - Found cast iron monument and updated ties.

September 25, 2002 - Established NAD 1983 (1996 adj.) Anoka County project coordinates by static GPS methods.

September 30, 2002 - Found cast iron monument and updated ties.

March 28, 2013 - Found cast iron monument flush. Verified position by VRS GPS methods. Updated ties.

March 6, 2018 - Found cast iron monument flush. Verified position by VRS GPS methods. Updated ties.