

# CERTIFICATE OF LOCATION OF GOVERNMENT CORNER

County of Anoka

State of Minnesota


## West 1/4 Corner of Sec. 27 Township 33 Range 25

On the 16th day of June, 1966, the described corner was evidenced by area resurvey

and to perpetuate the location of said corner, at the exact location thereof, a permanent marker was placed consisting of a red and white iron pipe with a sign attached facing south

AND on the 18th day of January, 2018, said permanent marker was found 2" square steel Telspar monument up 5'± w/sign attached. The ties were updated

Updated reference ties are as shown below.

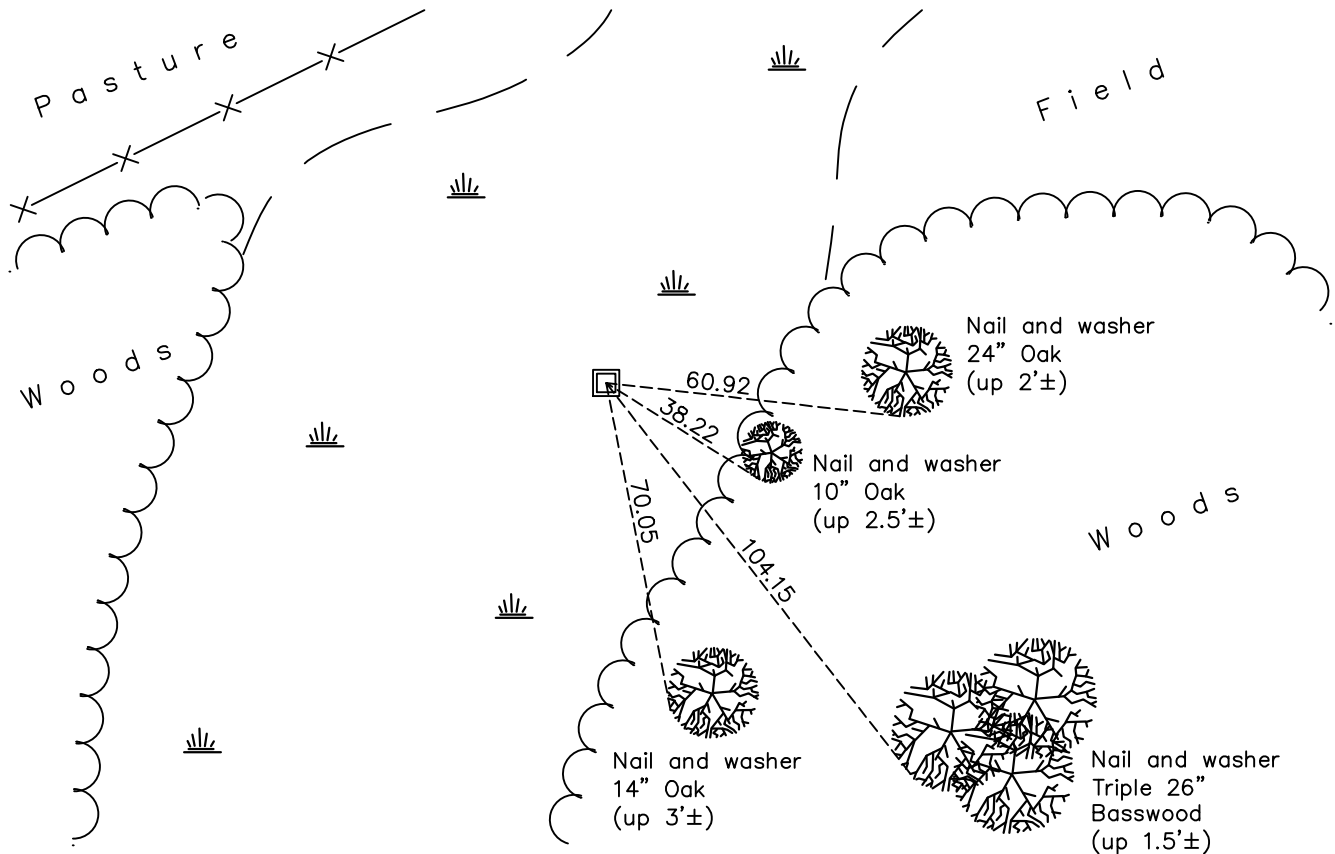

Revision Date

4/23/18

N.A.D. 1983 Coordinates  
(1996 Adjustment)

County Project Coordinates	
Northing	<u>204164.9248</u>
Easting	<u>452929.7182</u>
Date	<u>2/20/03</u>

I hereby certify that this United States public land survey monument record is correct and complete to the best of my knowledge and belief.

*David M Zieglsmeier* Date 6/11/21

David M. Zieglsmeier, Anoka County Surveyor

Minnesota License Number 46179

# HISTORY OF GOVERNMENT CORNER

Page No. 93

County of Anoka

State of Minnesota

## West 1/4 Corner of Sec. 27 Township 33 Range 25

### **CORNER HISTORY:**

May 1855 - This corner was established by James M. Marsh, Deputy Surveyor. Marsh marked the position by "set quarter section post" with one bearing tree marked as an accessory.

June 15, 1966 - Set red and white iron pipe up 3'± using area resurvey. Iron pipe is at intersection of old fence lines. Established ties to iron pipe.

July 22, 1969 - Found red and white pipe and updated ties.

July 31, 1973 - Found red and white pipe and updated ties.

July 28, 1976 - Found red and white pipe and updated ties.

July 23, 1979 - Found red and white pipe and updated ties.

August 3, 1982 - Found red and white pipe and updated ties.

June 22, 1987 - Found red and white pipe and updated ties.

September 8, 1988 - Found red and white pipe and updated ties.

July 18, 1994 - Found red and white pipe and updated ties.

February 20, 2003 - Established NAD 1983 (1996 adj.) Anoka County project coordinates by static GPS methods.

October 29, 2013 - Found red and white pipe w/sign attached and updated ties.

January 18, 2018 - Found 2" square steel Telspar monument up 5'± w/sign attached. Updated ties.