

CERTIFICATE OF LOCATION OF GOVERNMENT CORNER

County of Anoka


State of Minnesota

Center of Sec. 26, Township 33, Range 25

I hereby certify that on the 14th day of May, 1975, I found the described corner which was evidenced by a granite monument

and I further certify that to perpetuate the location of said corner, I did, at the exact location thereof, place a permanent marker consisting of a granite monument

which reference or witness monuments are located in the manner following:

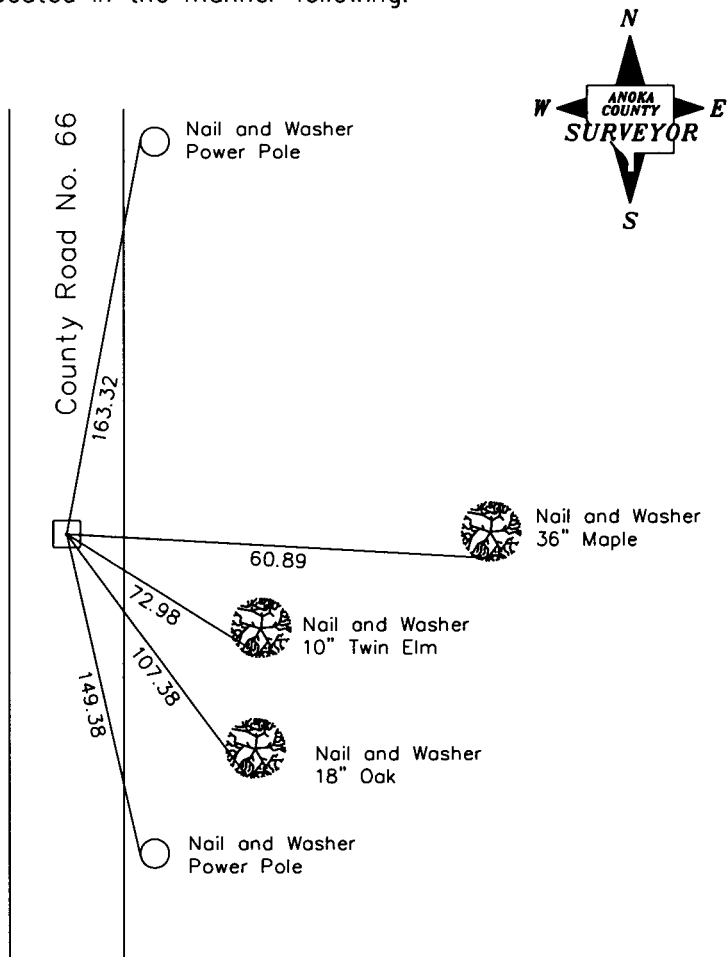

Revised date

7-26-76
7-19-79
8-3-82
7-12-85
7-5-89

N.A.D. 1983 Co-ordinates
(1996 Adjustment)

County Project Co-ordinates	State Plane Co-ordinates
Northing _____	Y _____
Easting _____	X _____

Date _____