

CERTIFICATE OF LOCATION OF GOVERNMENT CORNER

County of Anoka

State of Minnesota


Witness Corner of Sec. 26 Township 33 Range 25
(On west line of SE 1/4)

On the 14th day of May, 1975, the described corner was evidenced by a granite monument


and to perpetuate the location of said corner, at the exact location thereof, a permanent marker was placed consisting of the same granite monument with a sign and post on the north side

AND on the 29th day of October, 2013, said permanent marker was found and the ties were updated

Updated reference ties are as shown below.

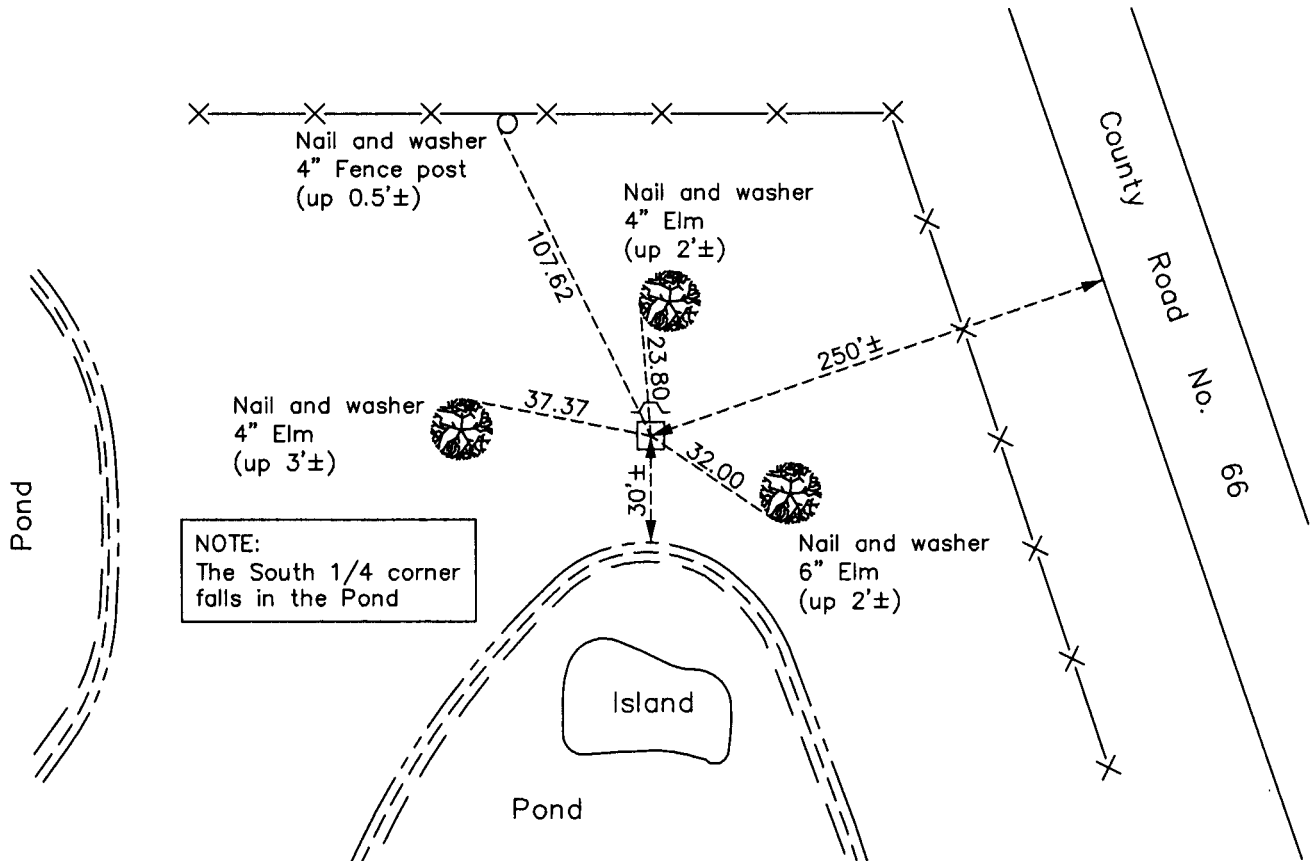

NOTE:
The South 1/4 corner falls in the Pond

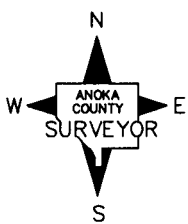

Revision Date
3/03/14

N.A.D. 1983 Coordinates
(1996 Adjustment)

County Project Coordinates	
Northing	201900.6941
Easting	460807.3398
Date	2/25/03

I hereby certify that this United States public land survey monument record is correct and complete to the best of my knowledge and belief.

Larry D. Hoium Date 3/03/14
 Larry D. Hoium, Anoka County Surveyor
 Minnesota License Number 18165