

CERTIFICATE OF LOCATION OF GOVERNMENT CORNER

County of Anoka

State of Minnesota


West 1/4 Corner of Sec. 25 Township 33 Range 25

On the 9th day of October, 1963, the described corner was evidenced by a granite monument with an etched "X"

and to perpetuate the location of said corner, at the exact location thereof, a permanent marker was placed consisting of the same granite monument

AND on the 27th day of March, 2018, said permanent marker was found flush and the ties were updated

Updated reference ties are as shown below.

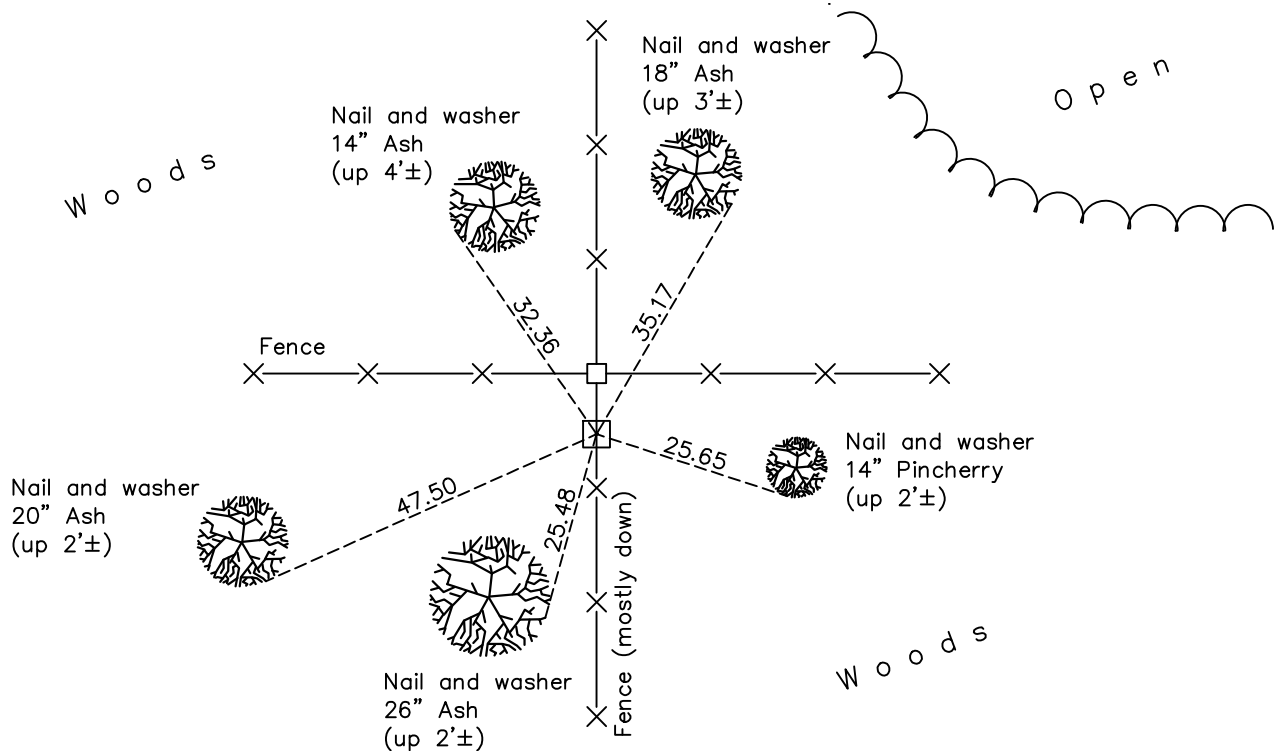

Revision Date

4/23/18

N.A.D. 1983 Coordinates
(1996 Adjustment)

County Project Coordinates	
Northing	<u>204079.9245</u>
Easting	<u>463400.5008</u>
Date	<u>2/25/03</u>

I hereby certify that this United States public land survey monument record is correct and complete to the best of my knowledge and belief.

David M Zieglmeier Date 6/11/21

David M. Zieglmeier, Anoka County Surveyor

Minnesota License Number 46179

HISTORY OF GOVERNMENT CORNER

Page No. 96

County of Anoka

State of Minnesota

West 1/4 Corner of Sec. 25 Township 33 Range 25

CORNER HISTORY:

May 1855 - This corner was established by James M. Marsh, Deputy Surveyor. Marsh marked the position by "set quarter section post" with two bearing trees marked as accessories.

August 10, 1945 - Harvey Cartwright found a granite monument and updated the ties.

October 9, 1963 - Found 6" x 6" granite monument flush and set to cardinal points. Updated ties.

August 17, 1965 - Found granite monument and updated ties.

July 28, 1969 - Found granite monument and updated ties.

August 1, 1973 - Found granite monument and updated ties.

July 28, 1976 - Found granite monument and updated ties.

July 25, 1979 - Found granite monument and updated ties.

August 9, 1982 - Found granite monument and updated ties.

July 2, 1985 - Found granite monument and updated ties.

July 10, 1989 - Found granite monument and updated ties.

June 30, 1994 - Found granite monument and updated ties.

February 25, 2003 - Found granite monument with "X" etched in top and updated ties. Established NAD 1983 (1996 adj.) Anoka County project coordinates by static GPS methods.

October 28, 2013 - Found granite monument and updated ties.

March 27, 2018 - Found granite monument flush and updated ties.