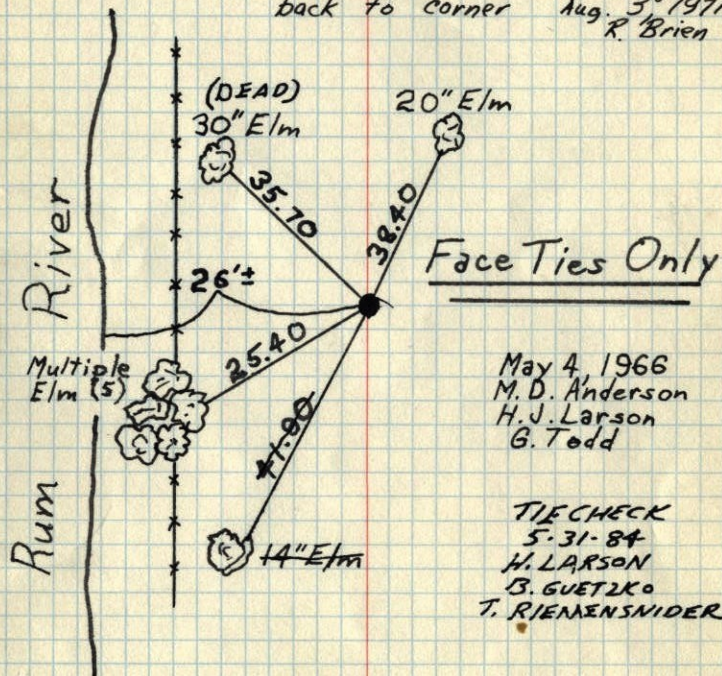


## W.C. on S. line Sec. 31-T33-R24

Set Cast Iron Monument down 0.2'

Took only face ties for location purposes only


Could not use nail + washers - Landowner complainedMiss/ins. would not let us get  
back to corner Aug. 3, 1971  
R. BrienTEMPERATURE CORRECTED  
AND HORIZONTALLY  
TAPED MEASUREMENTSROLAND W. ANDERSON  
COUNTY SURVEYOR  
ANOKA COUNTY, MINNESOTA

## W.C. on S. line Sec. 31-T33-R24

Set Cast Iron Monument down 0.2'

took only face ties for

location purposes only

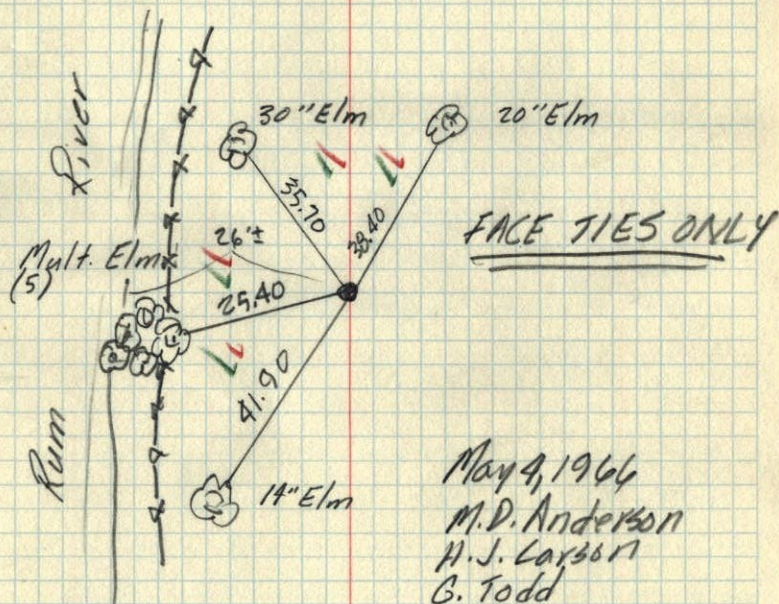could not use nail & washersTEMPERATURE CORRECTED  
AND HORIZONTALLY  
TAPED MEASUREMENTSROLAND W. ANDERSON  
COUNTY SURVEYOR  
ANOKA COUNTY, MINNESOTA