


Northeast corner of Sec. 15 T33 R24

Retied cast iron

P. 66

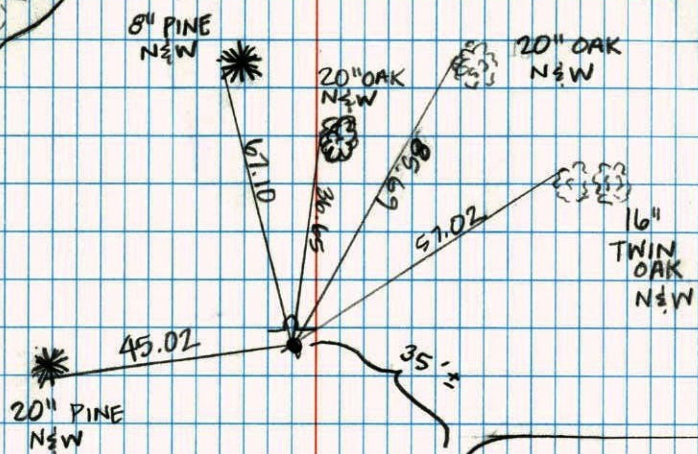

6.9.97
H. Askew
L. Grayson

OLD SIMS RD.

4