


39 ✓

SE corner of Sec. 32 + 33 R24

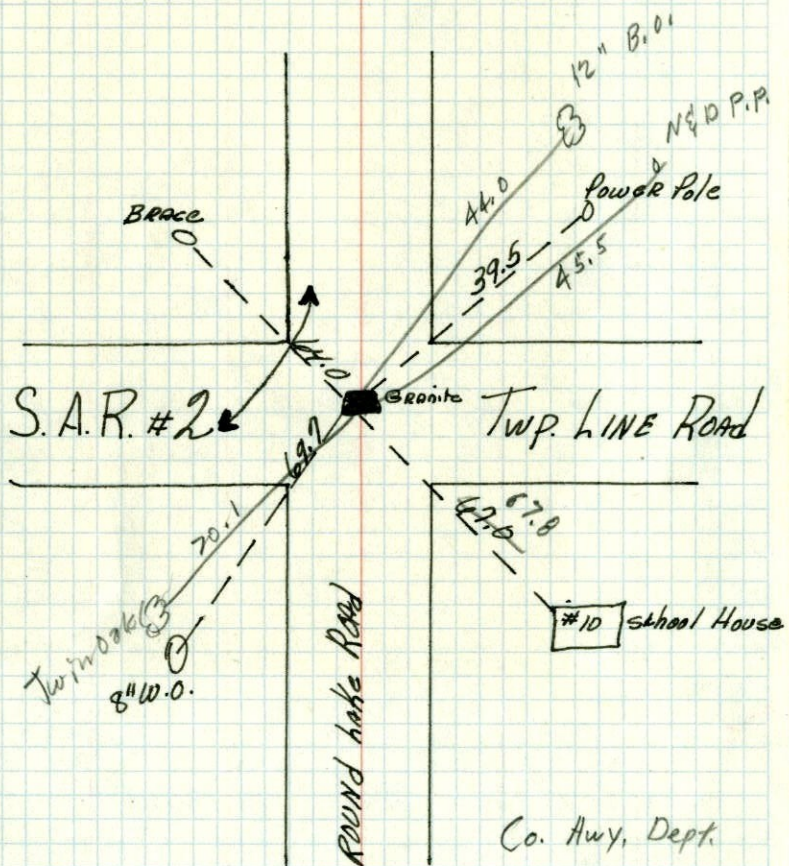

Anoka Co. Hwy. Dept.

SE. of Sec. 32, 33-24

Co. Hwy, Dept

Ties Gone

Corn. in Place
After Constr.

