

# CERTIFICATE OF LOCATION OF GOVERNMENT CORNER

County of Anoka

State of Minnesota



## Northwest Corner of Sec. 4 Township 33 Range 24

On the 15th day of April, 1959, the described corner was evidenced by an iron pipe

and to perpetuate the location of said corner, at the exact location thereof, a permanent marker was placed consisting of a cast iron monument

AND on the 29th day of October, 2019, said permanent marker was Reset with a cast iron monument and the ties were updated

Updated reference ties are as shown below.

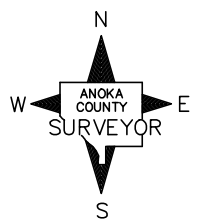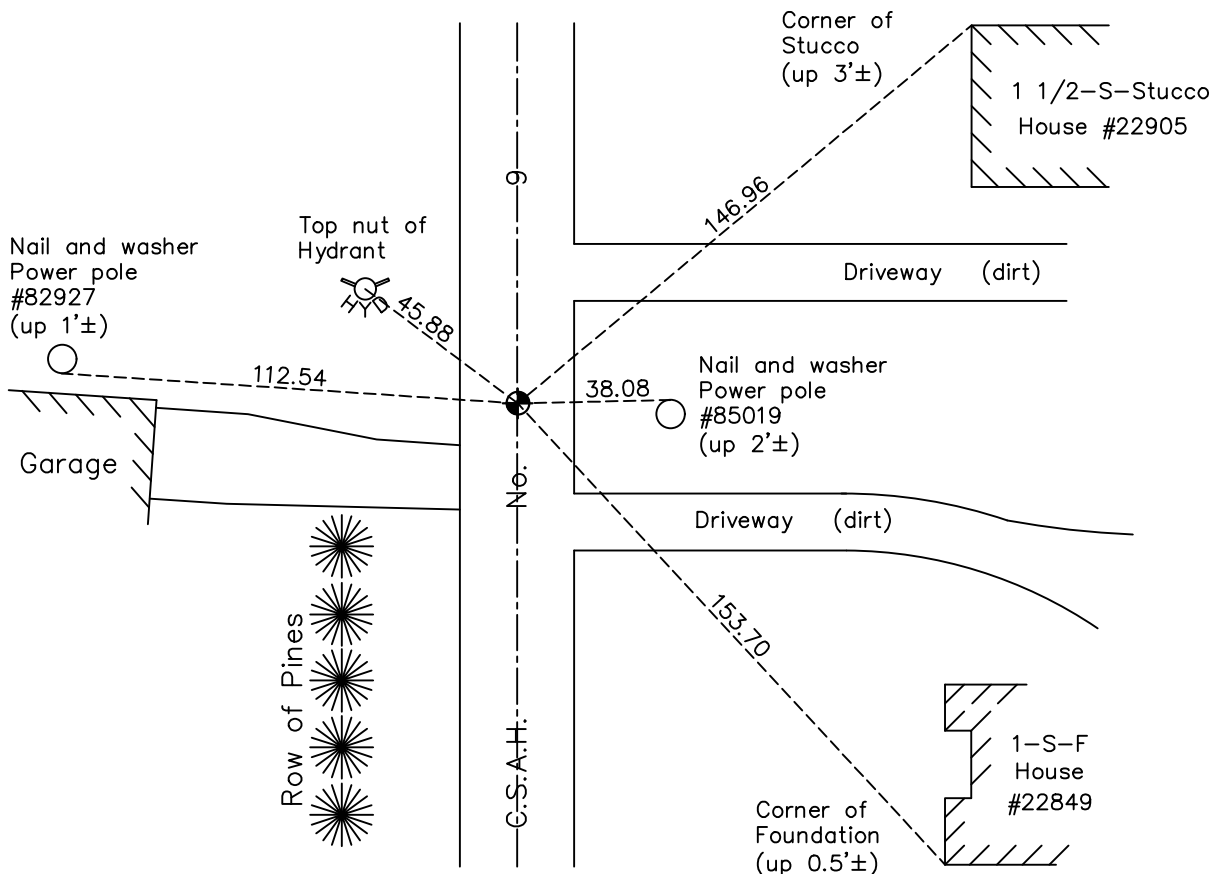

Revision Date  
12/3/19

N.A.D. 1983 Coordinates  
(1996 Adjustment)

|                            |                    |
|----------------------------|--------------------|
| County Project Coordinates |                    |
| Northing                   | <u>227450.3372</u> |
| Easting                    | <u>479283.3927</u> |
| Date                       | <u>4/24/01</u>     |

I hereby certify that this United States public land survey monument record is correct and complete to the best of my knowledge and belief.

*David M Zieglmeier* Date 7/27/21

David Zieglmeier Anoka County Surveyor  
Minnesota License Number 46179

# HISTORY OF GOVERNMENT CORNER

Page No. 9

County of Anoka

State of Minnesota

## Northwest Corner of Sec. 4 Township 33 Range 24

### **CORNER HISTORY:**

September 30, 1946 - Found granite monument and established ties to granite monument.

April 15, 1959 - Found 1" iron pipe down 0.75' under blacktop road that was replaced by the County highway department surveyors after road construction. Established ties to iron pipe.

August 3, 1965 - Found iron pipe and replaced with a cast iron monument flush and updated ties.

June 17, 1968 - Found cast iron monument and updated ties.

July 19, 1971 - Found cast iron monument and updated ties.

June 25, 1975 - Found cast iron monument and updated ties.

June 23, 1978 - Found cast iron monument and updated ties.

July 15, 1981 - Found cast iron monument and updated ties.

August 3, 1984 - Found cast iron monument and updated ties.

July 20, 1987 - Found cast iron monument and updated ties.

July 6, 1992 - Found cast iron monument and updated ties.

June 3, 1997 - Found cast iron monument and updated ties.

April 24, 2001 - Found cast iron monument, established NAD 1983 (1996 adj.) Anoka County project coordinates by static GPS methods and updated ties.

January 31, 2012 - Found cast iron monument, verified position by VRS GPS methods and updated ties.

April 11, 2017 - Found cast iron monument, verified position by VRS GPS methods and updated ties.

June 14, 2019 - Found cast iron monument, verified position by VRS GPS methods and updated ties prior to road construction. Removed monument.

October 29, 2019 - Set cast iron monument flush after road construction using static GPS methods. Verified position by VRS GPS methods and updated ties.