

CERTIFICATE OF LOCATION OF GOVERNMENT CORNER

County of Anoka

State of Minnesota

Meander Corner of Sec. 5 Township 33 Range 24



(on north line of section east of Rum River)

On the 23rd day of May, 1961, the described corner was evidenced by a solid iron bar

and to perpetuate the location of said corner, at the exact location thereof, a permanent marker was placed consisting of a cast iron monument with a sign and post on the north side

AND on the 19th day of November, 2020, said permanent marker was found flush with the surface and the ties were updated

Updated reference ties are as shown below.

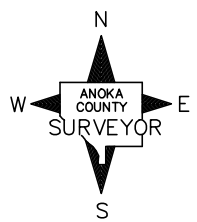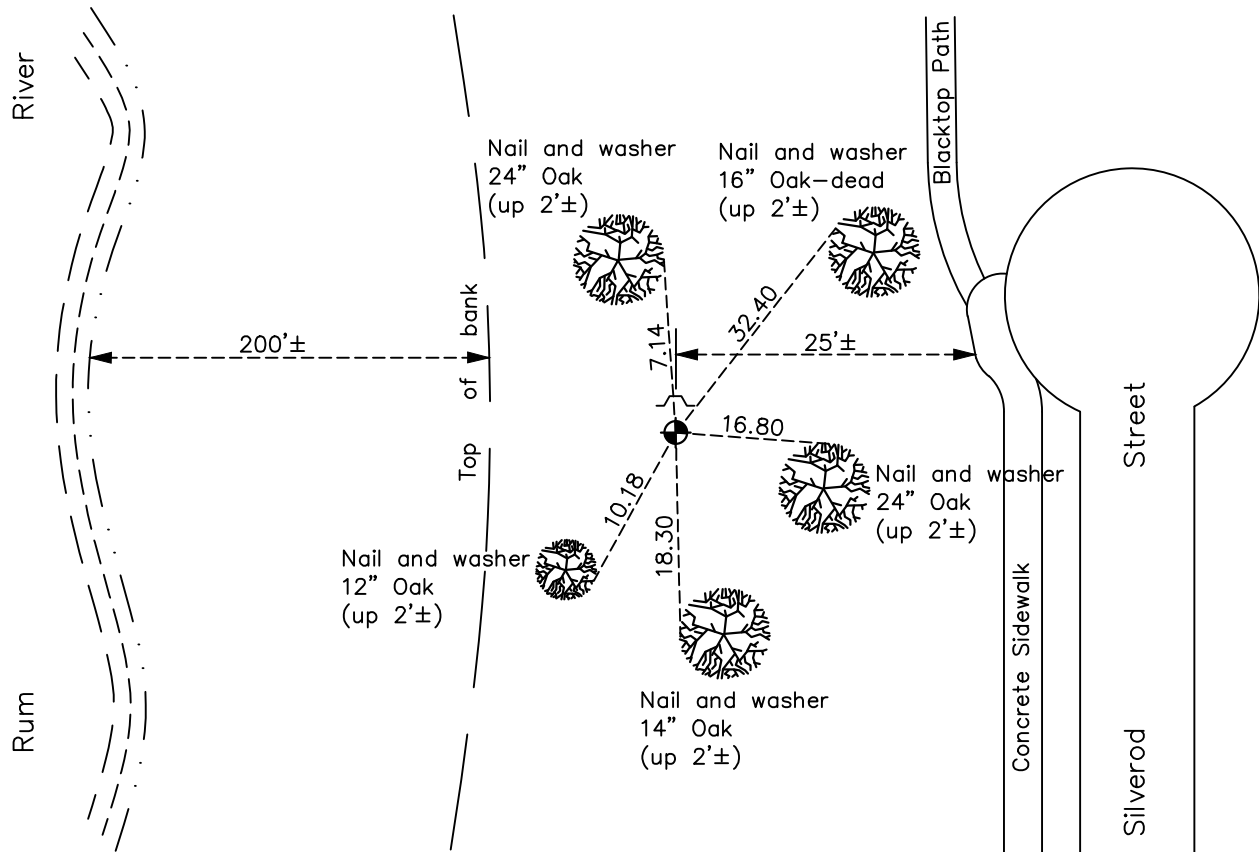

Revision Date
04/14/2021

N.A.D. 1983 Coordinates
(1996 Adjustment)

County Project Coordinates	
Northing	<u>227460.7456</u>
Easting	<u>476958.5562</u>
Date	<u>4/24/01</u>

I hereby certify that this United States public land survey monument record is correct and complete to the best of my knowledge and belief.

David M Zieglmeier Date 7/27/21

David Zieglmeier Anoka County Surveyor
Minnesota License Number 46179

HISTORY OF GOVERNMENT CORNER

Page No. 10

County of Anoka

State of Minnesota

Meander Corner of Sec. 5 Township 33 Range 24 (on north line of section east of Rum River)

CORNER HISTORY:

September 30, 1946 - Harvey Cartwright set a concrete monument on line between the North quarter corner and the Northeast corner of section 5, T33N, R24W. Established ties to monument.

May 23, 1961 - Found concrete monument missing as per Cartwright ties. Found solid iron bar with a 1" iron on the North edge of the bar. Updated ties.

July 16, 1965 - Found solid iron bar up 0.2'± and updated ties.

June 17, 1968 - Found solid iron bar with a 1" iron pipe up 0.8'± on the north edge. Updated ties.

July 28, 1971 - Found solid iron bar and replaced with a cast iron monument. Updated ties.

June 25, 1975 - Found cast iron monument and updated ties.

June 26, 1978 - Found cast iron monument and updated ties.

July 30, 1981 - Found cast iron monument and updated ties.

August 14, 1984 - Found cast iron monument and updated ties.

July 31, 1987 - Found cast iron monument and updated ties.

July 10, 1992 - Found cast iron monument and updated ties.

June 26, 1997 - Found cast iron monument and replaced sign on the north side. Updated ties.

April 24, 2001 - Found cast iron monument and updated ties. Established NAD 1983 (1996 adj.) Anoka County project coordinates by static GPS methods.

January 12, 2012 - Found cast iron monument and updated ties.

April 11, 2017 - Found cast iron monument flush and updated ties.

November 19, 2020 - Found cast iron monument flush. Verified position by VRS GPS methods. Updated ties.