

CERTIFICATE OF LOCATION OF GOVERNMENT CORNER

County of Anoka

State of Minnesota


Meander Corner of Sec. 5 Township 33 Range 24 (on north line of section west of Rum River)

On the 23rd day of May, 1961, the described corner was evidenced by a 2" iron pipe

and to perpetuate the location of said corner, at the exact location thereof, a permanent marker was placed consisting of a cast iron monument with a sign and post on the north side

AND on the 19th day of November, 2020, said permanent marker was found down 0.2'± with a sign and post on the north side and the ties were updated.

Updated reference ties are as shown below.

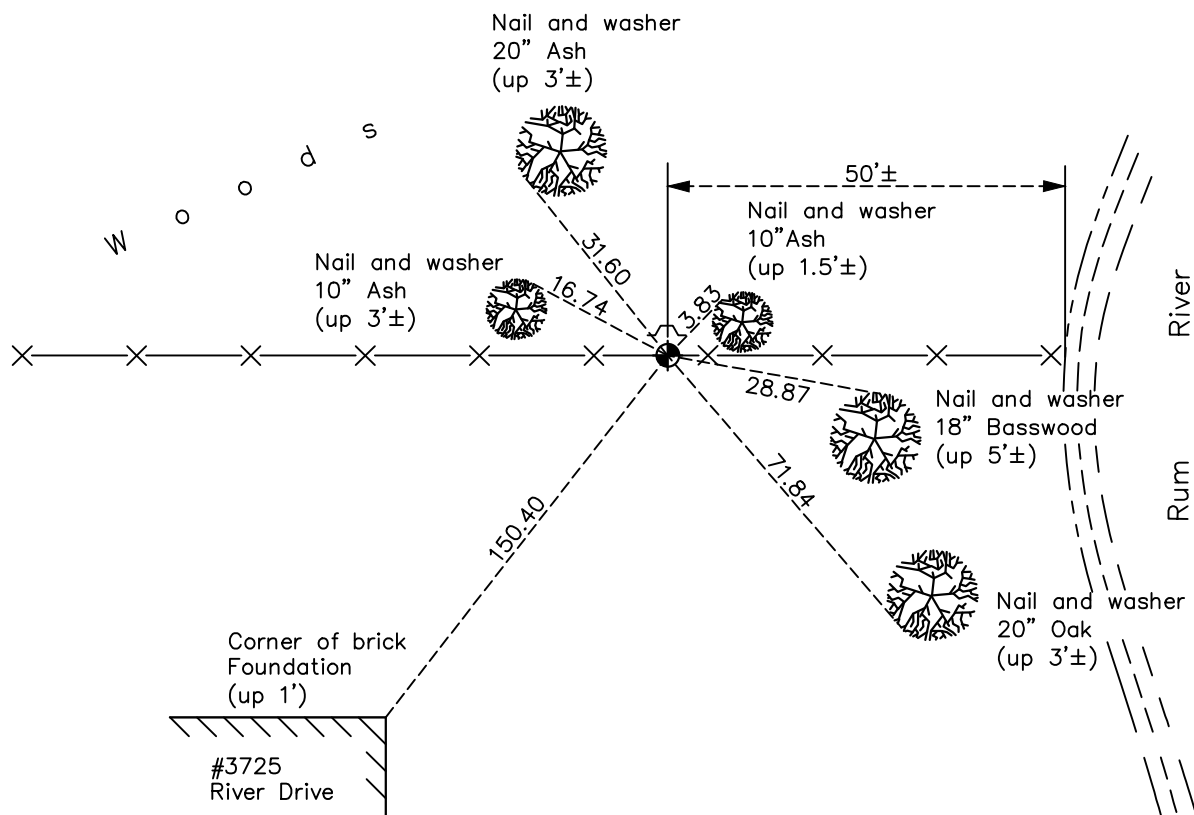

Revision Date

04/14/2021

N.A.D. 1983 Coordinates
(1996 Adjustment)

County Project Coordinates

Northing 227462.1126

Easting 476581.2748

Date 4/26/01

I hereby certify that this United States public land survey monument record is correct and complete to the best of my knowledge and belief.

David M Zieglmeier Date 7/27/21

David M. Zieglmeier, Anoka County Deputy Surveyor

Minnesota License Number 46179

HISTORY OF GOVERNMENT CORNER

Page No. 11

County of Anoka

State of Minnesota

Meander Corner of Sec. 5 Township 33 Range 24 (on north line of section west of Rum River)

CORNER HISTORY:

September 30, 1946 - Harvey Cartwright set a concrete monument on extended line from granite monument at Northwest corner and sixteenth corner on west side of river. Established ties to concrete monument.

May 23, 1961 - Found concrete monument per Cartwright ties missing or never set. Found 2" iron instead and the ties fit well.

July 16, 1965 - Found 2" iron and updated ties.

June 18, 1968 - Found 2" iron and updated ties.

July 28, 1971 - Found 2" iron flush and replaced with a cast iron monument up 0.1'±. Updated ties.

June 25, 1975 - Found cast iron monument and updated ties.

July 17, 1978 - Found cast iron monument and updated ties.

July 31, 1981 - Found cast iron monument and updated ties.

August 14, 1984 - Found cast iron monument and updated ties.

July 10, 1992 - Found cast iron monument and updated ties.

June 25, 1997 - Found cast iron monument and updated ties.

April 26, 2001 - Found cast iron monument and updated ties. Established NAD 1983 (1996 adj.) Anoka County project coordinates by static GPS methods.

January 18, 2012 - Found cast iron monument down 0.2'± and updated ties. Set sign and post on north side on April 4, 2012.

April 24, 2017 - Found cast iron monument and updated ties.

November 19, 2020 - Found cast iron monument and updated ties.