

CERTIFICATE OF LOCATION OF GOVERNMENT CORNER

County of Anoka

State of Minnesota


North $\frac{1}{4}$ Corner of Sec. 9 Township 33 Range 24

On the 8th day of August, 1975, the described corner was evidenced by a $\frac{1}{2}$ " iron pipe

and to perpetuate the location of said corner, at the exact location thereof, a permanent marker was placed consisting of a cast iron monument

AND on the 23rd day of November, 2020, said permanent marker was found flush and the ties were updated

Updated reference ties are as shown below.

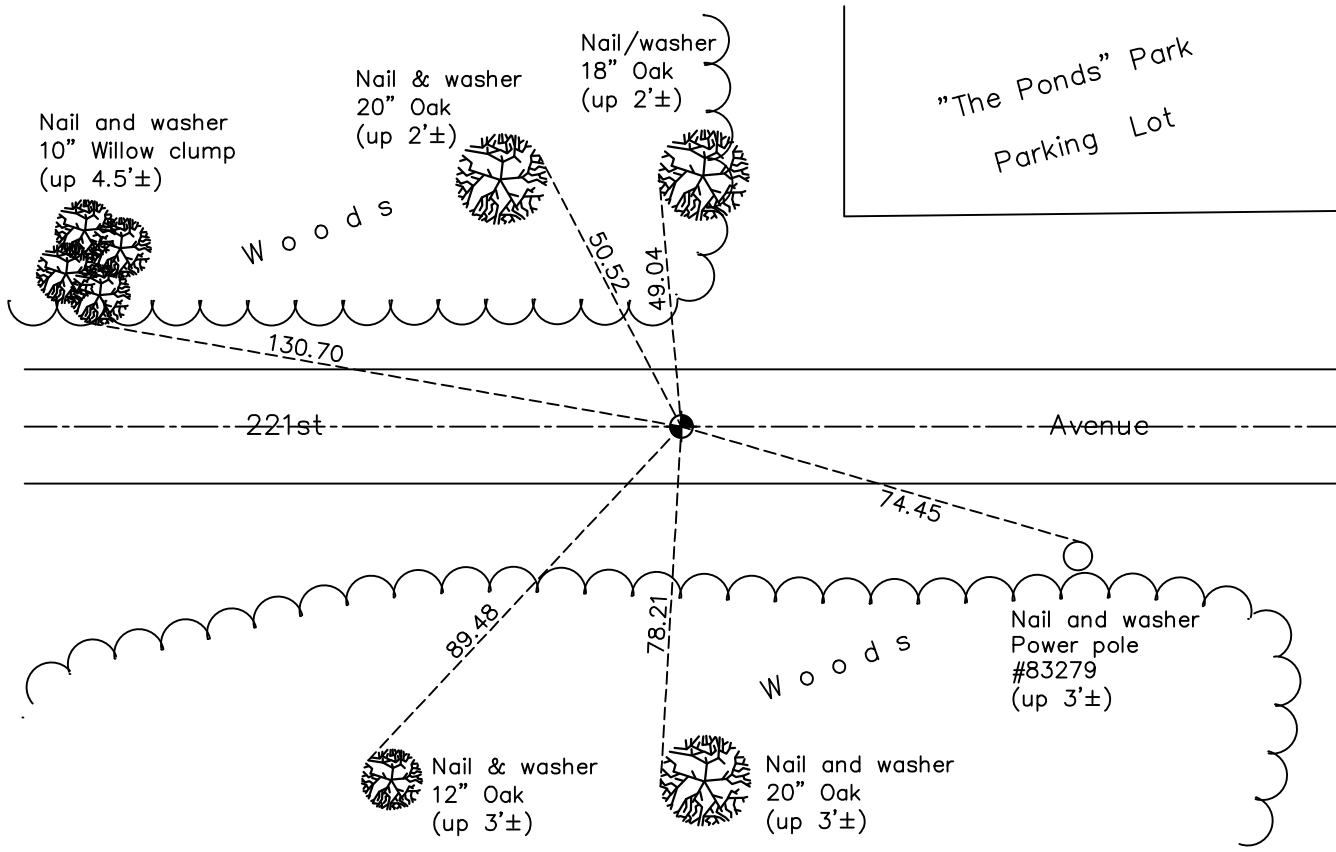

N

S

Revision Date

05/20/2021

N.A.D. 1983 Coordinates
(1996 Adjustment)

County Project Coordinates	
Northing	<u>222222.8256</u>
Easting	<u>481816.7411</u>
Date	<u>2/22/01</u>

I hereby certify that this United States public land survey monument record is correct and complete to the best of my knowledge and belief.

David M Zieglmeier Date 7/29/21

David Zieglmeier Anoka County Surveyor
Minnesota License Number 46179

HISTORY OF GOVERNMENT CORNER

Page No. 28

County of Anoka

State of Minnesota

North 1/4 Corner of Sec. 9 Township 33 Range 24

CORNER HISTORY:

July 10, 1975 - Found 1/2" iron pipe down 0.5'± and updated ties.

August 8, 1975 - Found 1/2" iron pipe and replaced with a cast iron monument down 0.5'±.

June 28, 1978 - Found cast iron monument and updated ties.

July 15, 1981 - Found cast iron monument and updated ties.

August 7, 1984 - Found cast iron monument and updated ties.

July 16, 1987 - Found cast iron monument and updated ties.

June 28, 1992 - Found cast iron monument and updated ties.

June 27, 1997 - Found monument and set construction ties prior to construction. Removed monument.

May 18, 1999 - Reset cast iron monument after construction. Updated ties.

February 22, 2001 - Found cast iron monument and updated ties. Established NAD 1983 (1996 adj.) Anoka County project coordinates by static GPS methods.

September 8, 2011 - Found cast iron monument. Verified position by VRS GPS methods. Updated ties.

May 18, 2015 - Found cast iron monument, verified position by VRS GPS methods and updated ties prior to road construction. Loosened monument top.

August 25, 2015 - Raised monument top flush with road after construction.

April 5, 2017 - Found cast iron monument flush and updated ties.

November 23, 2020 - Found cast iron monument flush and updated ties.