

CERTIFICATE OF LOCATION OF GOVERNMENT CORNER

County of Anoka

State of Minnesota



South 1/4 Corner of Sec. 5 Township 33 Range 24

On the 19th day of June, 1961, the described corner was evidenced by a 1/2" pinched iron pipe

and to perpetuate the location of said corner, at the exact location thereof, a permanent marker was placed consisting of a cast iron monument with a sign and post on the north side

AND on the 20th day of November, 2020, said permanent marker was found down 0.5'± and the ties were updated

Updated reference ties are as shown below.

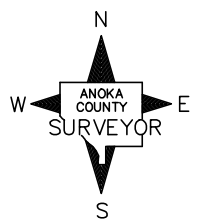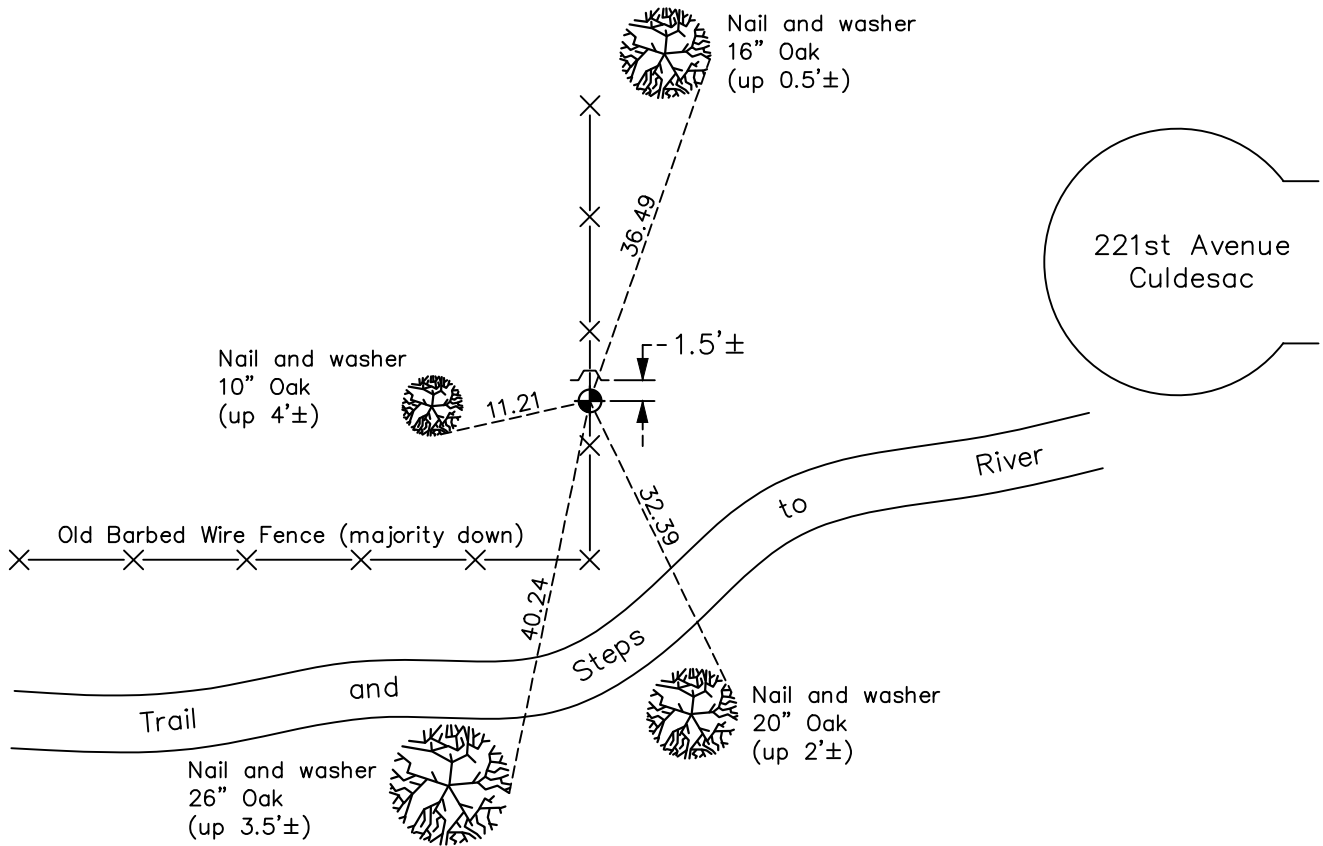

Revision Date
05/20/2021

N.A.D. 1983 Coordinates
(1996 Adjustment)

County Project Coordinates	
Northing	<u>222292.4351</u>
Easting	<u>476553.7735</u>
Date	<u>4/27/01</u>

I hereby certify that this United States public land survey monument record is correct and complete to the best of my knowledge and belief.

David M Zieglmeier Date 7/29/21

David Zieglmeier Anoka County Surveyor
Minnesota License Number 46179

HISTORY OF GOVERNMENT CORNER

Page No. 31

County of Anoka

State of Minnesota

South 1/4 Corner of Sec. 5 Township 33 Range 24

CORNER HISTORY:

June 19, 1961 - Found 1/2" pinched iron pipe flush and updated ties.

June 21, 1968 - Found iron pipe and replaced with a cast iron monument. Updated ties.

August 13, 1971 - Found cast iron monument and updated ties.

July 2, 1975 - Found cast iron monument and updated ties.

June 29, 1978 - Found cast iron monument and updated ties.

July 23, 1981 - Found cast iron monument and updated ties.

August 10, 1984 - Found cast iron monument and updated ties.

July 24, 1987 - Found cast iron monument and updated ties.

July 10, 1992 - Found cast iron monument and updated ties.

July 1, 1997 - Found cast iron monument and updated ties.

April 27, 2001 - Found cast iron monument and updated ties. Established NAD 1983 (1996 adj.) Anoka County project coordinates by static GPS methods.

December 30, 2011 - Found cast iron monument down 0.5'± and updated ties.

April 19, 2017 - Found cast iron monument and updated ties.

November 20, 2020 - Found cast iron monument down 0.5'± and updated ties.