

CERTIFICATE OF LOCATION OF GOVERNMENT CORNER

County of Anoka

State of Minnesota


West 1/4 Corner of Sec. 10 Township 33 Range 24

On the 23rd day of August, 1960, the described corner was evidenced by a concrete monument

and to perpetuate the location of said corner, at the exact location thereof, a permanent marker was placed consisting of a red and white iron pipe with a sign attached

AND on the 2nd day of December, 2020, said permanent marker was found up 3'± and the ties were updated

Updated reference ties are as shown below.

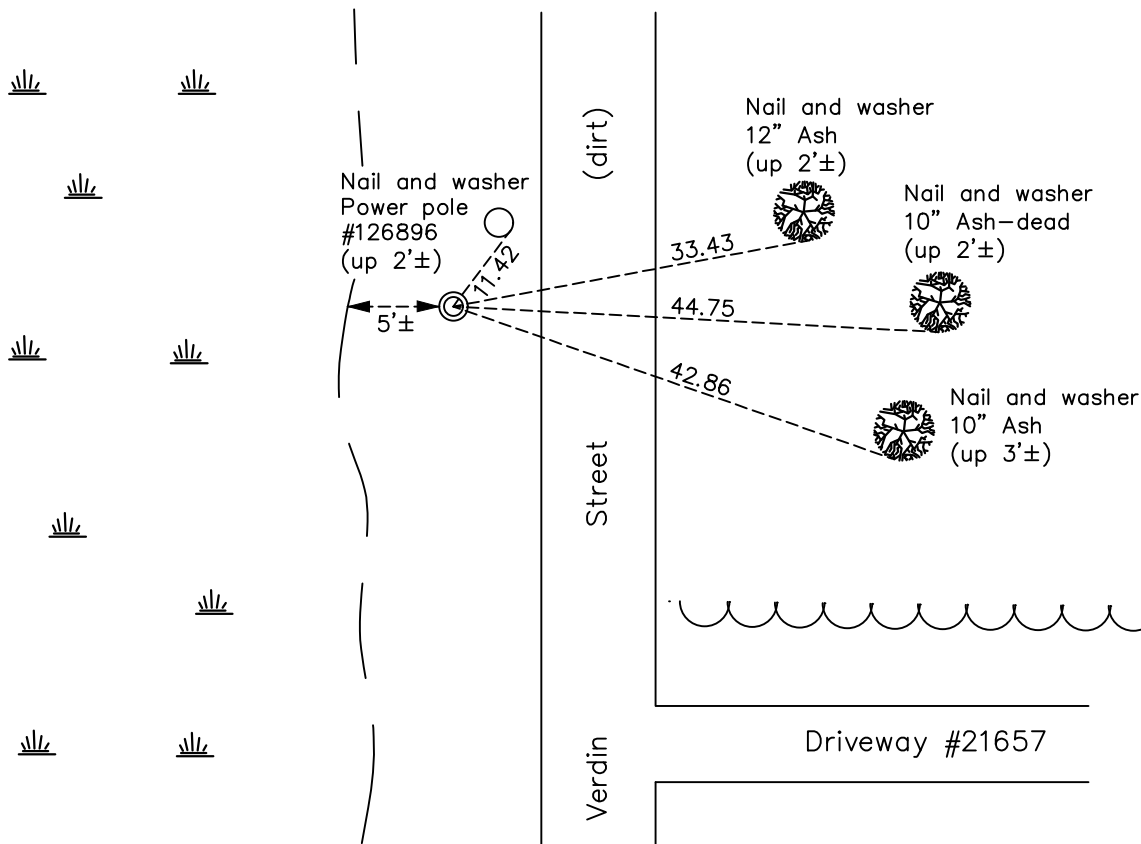

Revision Date

05/24/2021

N.A.D. 1983 Coordinates
(1996 Adjustment)

County Project Coordinates	
Northing	<u>219548.7001</u>
Easting	<u>484448.2449</u>
Date	<u>5/10/01</u>

I hereby certify that this United States public land survey monument record is correct and complete to the best of my knowledge and belief.

David M Zieglmeier Date 7/29/21

David Zieglmeier Anoka County Surveyor
Minnesota License Number 46179

HISTORY OF GOVERNMENT CORNER

Page No. 40

County of Anoka

State of Minnesota

West 1/4 Corner of Sec. 10 Township 33 Range 24

CORNER HISTORY:

December 20, 1944 - Harvey Cartwright set a concrete monument using fence corner checked by sixteenth corner and section corner North. Established ties to concrete monument.

August 23, 1960 - Found concrete monument leaning southeasterly. Updated ties.

June 5, 1964 - Found concrete monument and replaced with a 1-1/2" x 10' red and white iron pipe up 4.5'± after straightening concrete. New straight position is 0.53' north and 0.75' west of old leaning position. Ties to be updated in winter.

September 8, 1965 - Found red and white iron pipe up 4.5'± and updated ties.

June 27, 1968 - Found red and white iron pipe. Too wet to check ties.

January 23, 1974 - Found red and white iron pipe.

July 24, 1981 - Found red and white iron pipe and updated ties.

August 14, 1984 - Found red and white iron pipe and updated ties.

July 27, 1987 - Found red and white iron pipe and updated ties.

July 14, 1992 - Found red and white iron pipe and updated ties.

June 19, 1997 - Found red and white iron pipe with sign and post on the north side. Updated ties.

May 10, 2001 - Found red and white iron pipe and updated ties. Established NAD 1983 (1996 adj.) Anoka County project coordinates by static GPS methods.

November 10, 2011 - Found red and white iron pipe w/sign attached. Verified position by VRS GPS methods. Updated ties.

April 2017 - Found red and white iron pipe w/sign up 3'±. Verified position by VRS GPS methods. Updated ties.

December 2, 2020 - Found red and white iron pipe w/sign up 3'±. Verified position by VRS GPS methods. Updated ties.