

CERTIFICATE OF LOCATION OF GOVERNMENT CORNER

County of Anoka

State of Minnesota


East 1/4 Corner of Sec. 16 Township 33 Range 24

On the 29th day of October, 1965, the described corner was evidenced by area resurvey

and to perpetuate the location of said corner, at the exact location thereof, a permanent marker was placed consisting of a cast iron monument with a sign and post on the east side

AND on the 14th day of December, 2020, said permanent marker was found down 0.1'± with a sign and post on the east side and the ties were updated

Updated reference ties are as shown below.

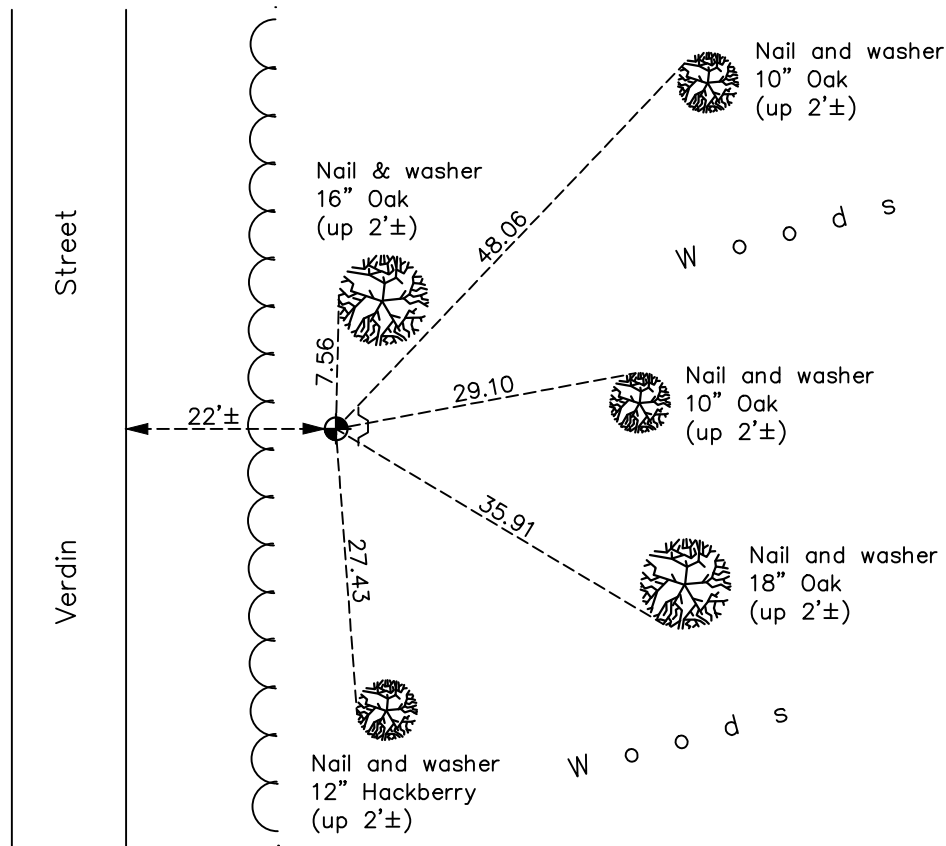

Revision Date

06/10/2021

N.A.D. 1983 Coordinates
(1996 Adjustment)

County Project Coordinates	
Northing	<u>214230.9194</u>
Easting	<u>484442.6795</u>
Date	<u>5/15/01</u>

I hereby certify that this United States public land survey monument record is correct and complete to the best of my knowledge and belief.

David M Zieglmeier Date 7/30/21

David Zieglmeier Anoka County Surveyor
Minnesota License Number 46179

HISTORY OF GOVERNMENT CORNER

Page No. 65

County of Anoka

State of Minnesota

East 1/4 Corner of Sec. 16 Township 33 Range 24

CORNER HISTORY:

September 8, 1964 - Set cast iron monument using area resurvey. Established ties to monument.

July 21, 1965 - Found cast iron monument and updated ties.

October 29, 1965 - Reset cast iron monument flush at revised position using resurvey adjustment. Updated ties.

July 1, 1968 - Found cast iron monument and updated ties.

July 3, 1973 - Found cast iron monument and updated ties.

July 3, 1975 - Found cast iron monument and updated ties.

July 5, 1978 - Found cast iron monument and updated ties.

July 24, 1981 - Found cast iron monument and updated ties.

August 14, 1984 - Found cast iron monument and updated ties.

July 30, 1987 - Found cast iron monument and updated ties.

July 9, 1992 - Found cast iron monument and updated ties.

June 26, 1997 - Found cast iron monument and updated ties.

May 15, 2001 - Found cast iron monument and updated ties. Established NAD 1983 (1996 adj.) Anoka County project coordinates by static GPS methods.

November 10, 2011 - Found cast iron monument. Verified position by VRS GPS methods. Updated ties. Set sign and post on the East side 4/6/2012.

April 7, 2017 - Found cast iron monument down 0.1'± and updated ties.

December 14, 2020 - Found cast iron monument down 0.1'± verified position by VRS GPS methods. And updated ties.