

# CERTIFICATE OF LOCATION OF GOVERNMENT CORNER

County of Anoka

State of Minnesota


## East 1/4 Corner of Sec. 20 Township 33 Range 24

On the 16th day of September, 1964, the described corner was evidenced by area resurvey

and to perpetuate the location of said corner, at the exact location thereof, a permanent marker was placed consisting of a cast iron monument

AND on the 25th day of October, 2019, said permanent marker was Reset with a cast iron monument flush and the ties were updated

Updated reference ties are as shown below.

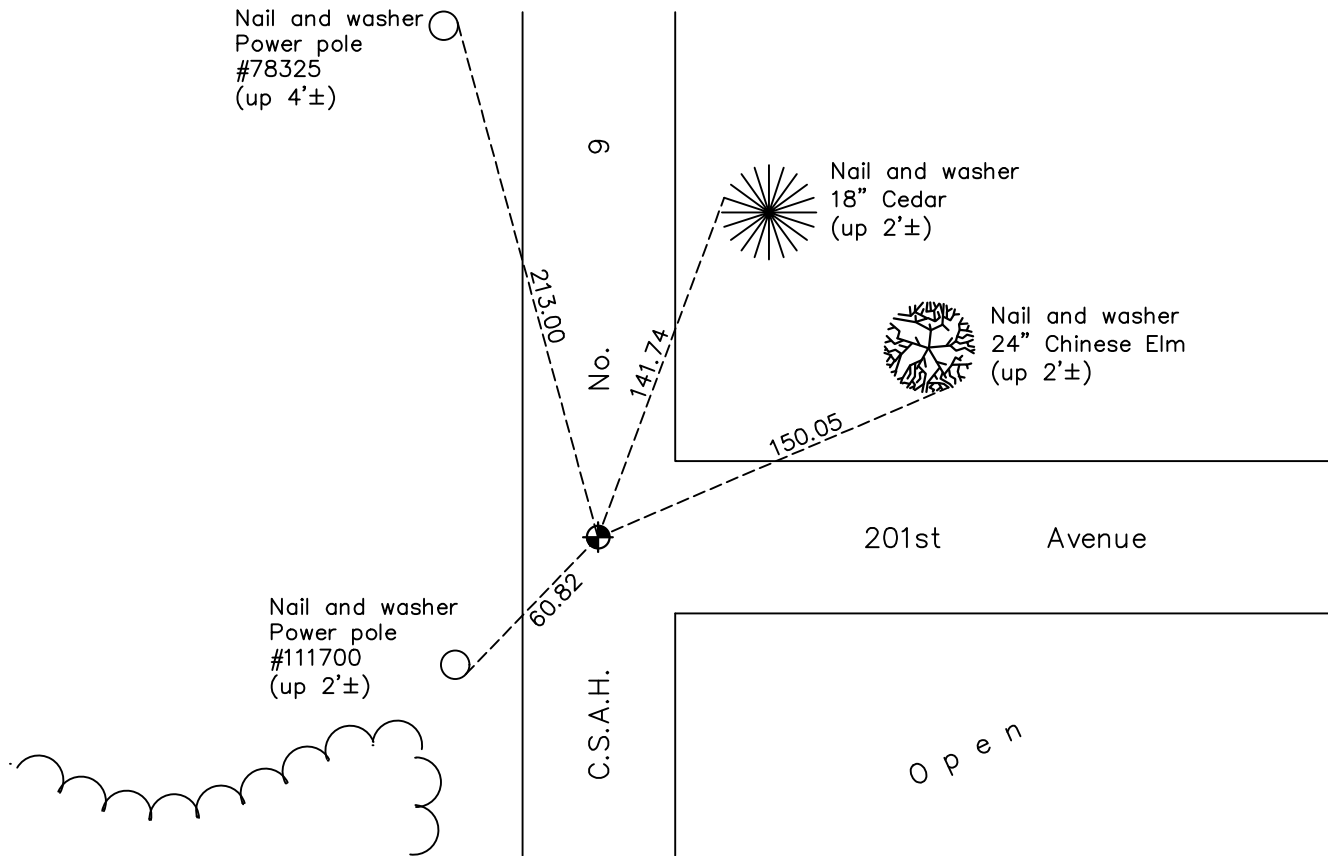

Revision Date

12/5/19

N.A.D. 1983 Coordinates  
(1996 Adjustment)

County Project Coordinates	
Northing	<u>209082.0522</u>
Easting	<u>479232.7741</u>
Date	<u>6/26/01</u>

I hereby certify that this United States public land survey monument record is correct and complete to the best of my knowledge and belief.

*David M Zieglmeier* Date 7/30/21

David Zieglmeier Anoka County Surveyor  
Minnesota License Number 46179

# HISTORY OF GOVERNMENT CORNER

Page No. 86

County of Anoka

State of Minnesota

## East 1/4 Corner of Sec. 20 Township 33 Range 24

### **CORNER HISTORY:**

September 16, 1964 - Found 1/2" iron pipe flush, set by J. Kurth. Established ties to iron pipe.

August 3, 1965 - Found iron pipe and replaced with a cast iron monument. Updated ties.

June 28, 1968 - Found cast iron monument and updated ties.

July 23, 1971 - Found cast iron monument and updated ties.

July 7, 1975 - Found cast iron monument and updated ties.

July 7, 1978 - Found cast iron monument and updated ties.

July 22, 1981 - Found cast iron monument and updated ties.

August 3, 1984 - Found cast iron monument and updated ties.

July 17, 1987 - Found cast iron monument and updated ties.

July 7, 1992 - Found cast iron monument and updated ties.

June 4, 1997 - Found cast iron monument and updated ties.

June 26, 2001 - Established NAD 1983 (1996 adj.) Anoka County project coordinates by static GPS methods.

March 27, 2012 - Found cast iron monument, verified position by VRS GPS methods and updated ties.

May 22, 2017 - Found cast iron monument, verified position by VRS GPS methods and updated ties.

June 13, 2019 - Found cast iron monument, verified position by VRS GPS methods and updated ties prior to road construction. Removed monument.

October 25, 2019 - Set cast iron monument flush after road construction using static GPS methods. Verified position by VRS GPS methods and updated ties.