

CERTIFICATE OF LOCATION OF GOVERNMENT CORNER

County of Anoka

State of Minnesota


North 1/4 Corner of Sec. 25 Township 33 Range 24

On the 30th day of August, 1971, the described corner was evidenced by area resurvey

and to perpetuate the location of said corner, at the exact location thereof, a permanent marker was placed consisting of a cast iron monument

AND on the 9th day of December, 2020, said permanent marker was found flush to surface and updated ties.

Updated reference ties are as shown below.

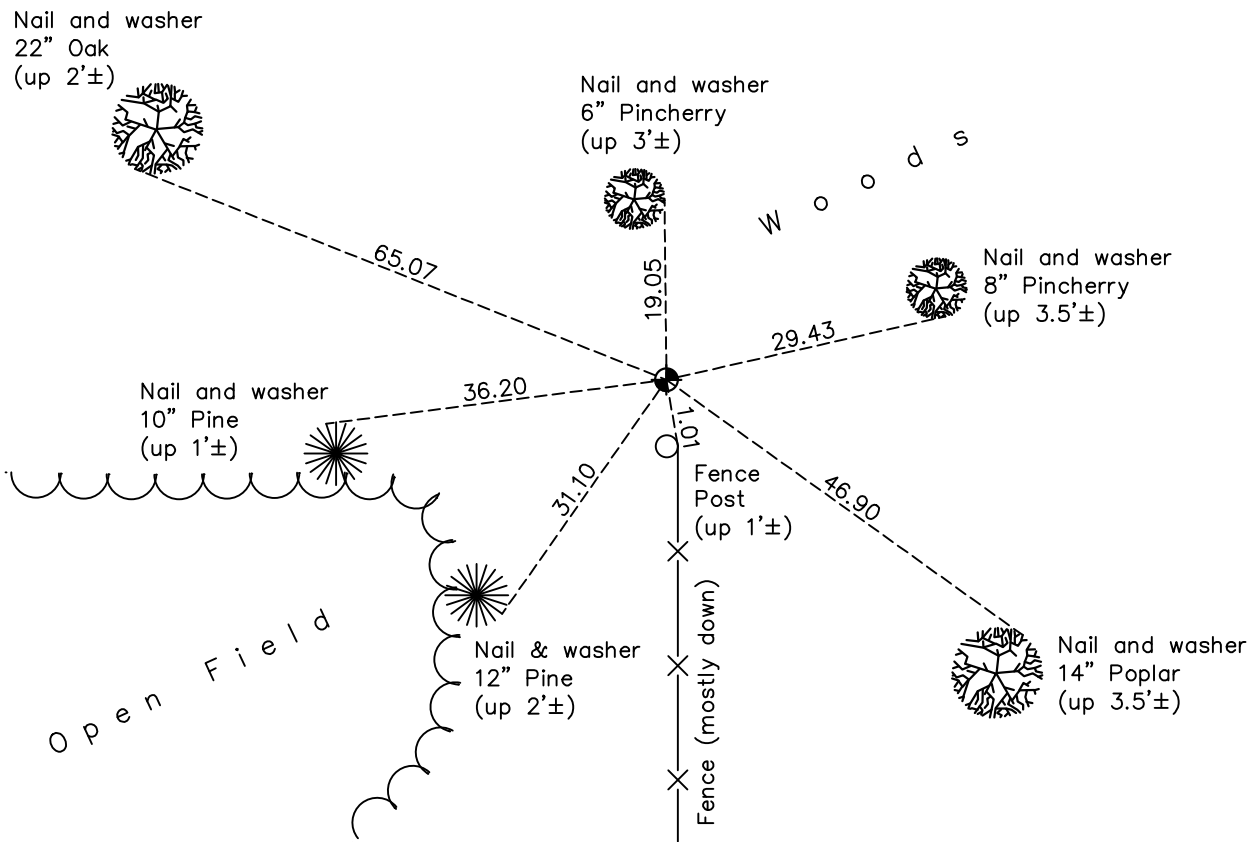

Revision Date

06/11/2021

N.A.D. 1983 Coordinates
(1996 Adjustment)

County Project Coordinates	
Northing	206409.4482
Easting	497608.6500
Date	7/03/01

I hereby certify that this United States public land survey monument record is correct and complete to the best of my knowledge and belief.

David M Zieglmeier Date 7/30/21

David Zieglmeier Anoka County Surveyor
Minnesota License Number 46179

HISTORY OF GOVERNMENT CORNER

Page No. 92

County of Anoka

State of Minnesota

North 1/4 Corner of Sec. 25 Township 33 Range 24

CORNER HISTORY:

August 30, 1971 - Set cast iron monument flush using area resurvey. Established ties to monument.

July 10, 1975 - Found cast iron monument and updated ties.

July 10, 1978 - Found cast iron monument and updated ties.

July 27, 1981 - Found cast iron monument and updated ties.

August 16, 1984 - Found cast iron monument and updated ties.

July 15, 1992 - Found cast iron monument and updated ties.

July 9, 1997 - Found cast iron monument and updated ties.

July 3, 2001 - Established NAD 1983 (1996 adj.) Anoka County project coordinates by static GPS methods.

February 14, 2012 - Found cast iron monument up 0.7'± and updated ties. Monument in need of lowering.

Unknown date - Found cast iron monument up 0.5'±. Verified position by VRS GPS methods. Updated ties.

August 22, 2017 - Found cast iron monument up 1'± and lowered to 0.1'± above the surface. Updated ties.

December 9, 2020 - Found cast iron monument flush. Verified position by VRS GPS methods. Updated ties.