

CERTIFICATE OF LOCATION OF GOVERNMENT CORNER

County of Anoka

State of Minnesota



East 1/16 Corner of Sec. 21 Township 33 Range 24 (on east line of SE1/4)

On the 24th day of April, 1973, the described corner was evidenced by area resurvey

and to perpetuate the location of said corner, at the exact location thereof, a permanent marker was placed consisting of a cast iron monument with a sign and post on the south side

AND on the 23rd day of February, 2021, said permanent marker was found flush and the ties were updated

Updated reference ties are as shown below.

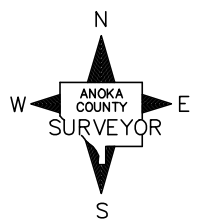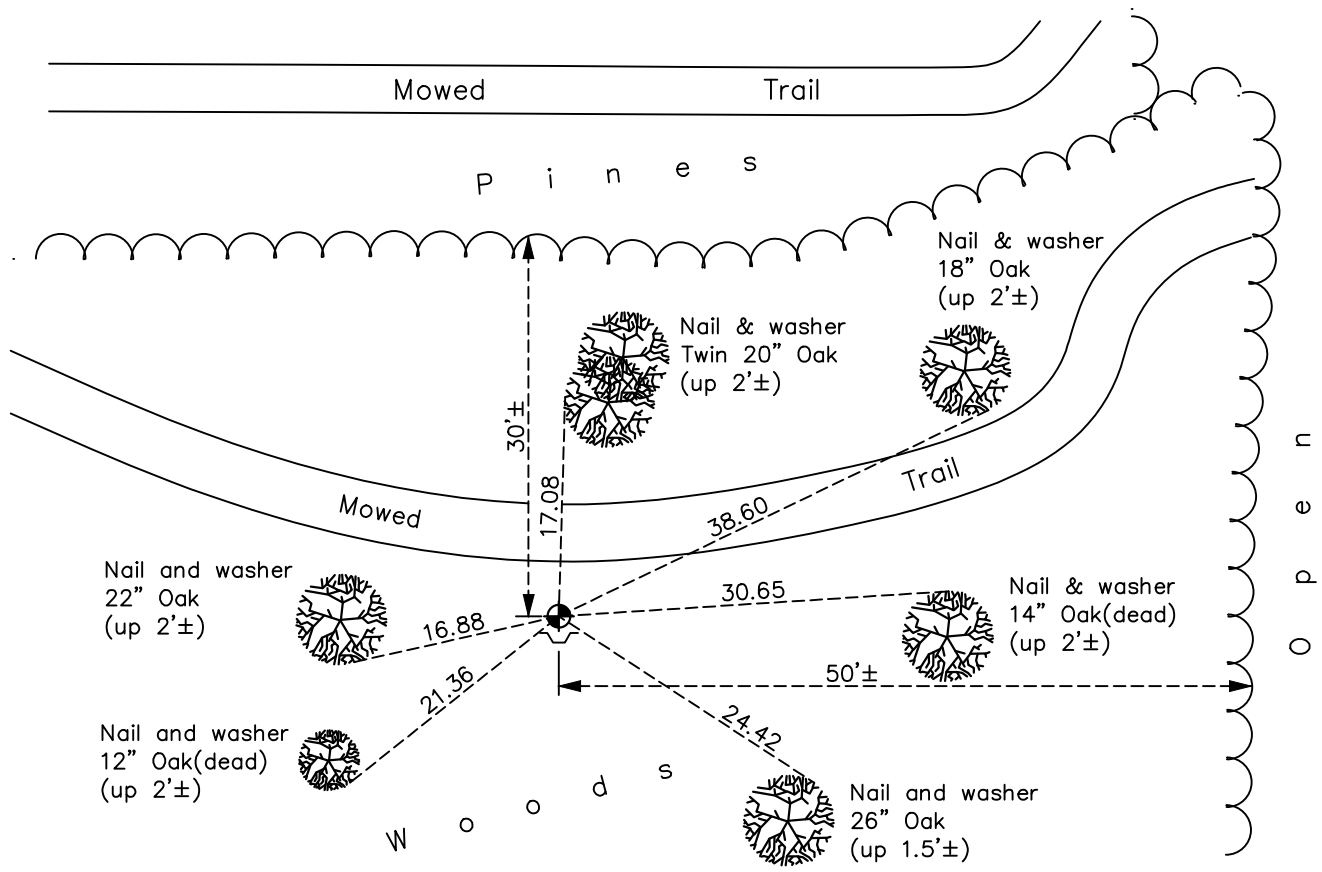

N.A.D. 1983 Coordinates
(1996 Adjustment)

County Project Coordinates	
Northing	<u>207709.2353</u>
Easting	<u>484500.4897</u>
Date	<u>2/21/02</u>

I hereby certify that this United States public land survey monument record is correct and complete to the best of my knowledge and belief.

David M Zieglmeier Date 7/30/21

David Zieglmeier Anoka County Surveyor
Minnesota License Number 46179

Revision Date
06/11/2021

HISTORY OF GOVERNMENT CORNER

Page No. 97

County of Anoka

State of Minnesota

East 1/16 Corner of Sec. 21 Township 33 Range 24
(on east line of SE1/4)

CORNER HISTORY:

April 24, 1973 - Set cast iron monument using area resurvey. Established ties to monument. Set sign and post 1'± south of monument.

July 9, 1975 - Found cast iron monument w/sign and post on the south side. Updated ties.

July 11, 1978 - Found cast iron monument and updated ties.

July 27, 1981 - Found cast iron monument and updated ties.

August 17, 1984 - Found cast iron monument and updated ties.

July 31, 1987 - Found cast iron monument and updated ties.

May 4, 1993 - Found cast iron monument and updated ties.

July 9, 1997 - Found cast iron monument and updated ties.

February 21, 2002 - Found cast iron monument and updated ties. Established NAD 1983 (1996 adj.) Anoka County project coordinates by static GPS methods.

February 1, 2012 - Found cast iron monument and updated ties.

May 24, 2017 - Found cast iron monument flush and updated ties.

February 23, 2021 - Found cast iron monument flush and updated ties.