

CERTIFICATE OF LOCATION OF GOVERNMENT CORNER

County of Anoka

State of Minnesota


Center Corner of Sec. 27 Township 33 Range 24

On the 14th day of September, 1967, the described corner was evidenced by area resurvey

and to perpetuate the location of said corner, at the exact location thereof, a permanent marker was placed consisting of a cast iron monument

AND on the 23rd day of June, 2022, said permanent marker was a P.K. nail. Replaced with a 1/2" iron pipe and A.C. cap flush. Verified position by VRS GPS methods and updated ties.

Updated reference ties are as shown below.

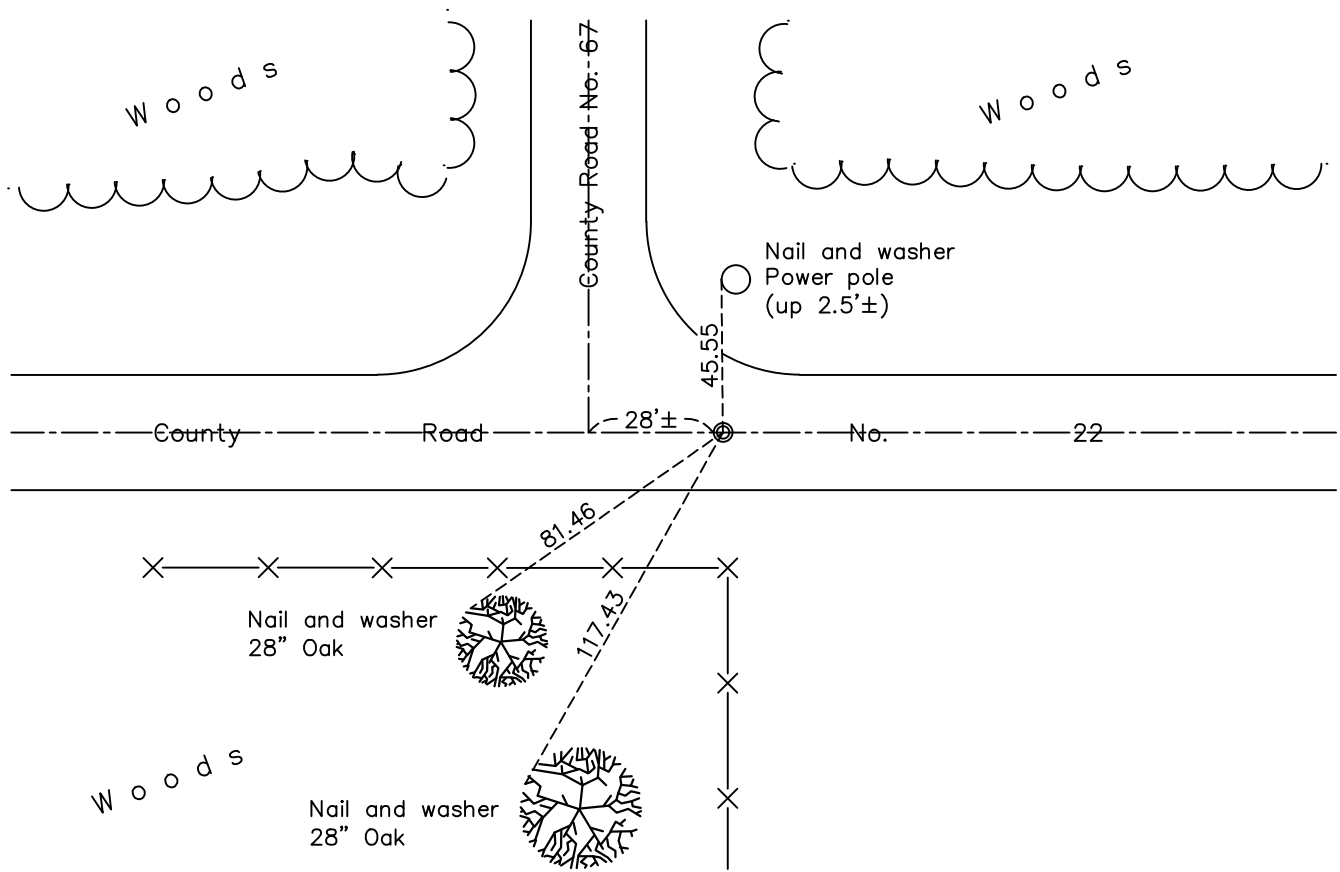

N.A.D. 1983 Coordinates
(1996 Adjustment)

County Project Coordinates	
Northing	<u>203714.7860</u>
Easting	<u>487154.8430</u>
Date	<u>6/23/2022</u>

Revision Date
7/6/2022

I hereby certify that this United States public land survey monument record is correct and complete to the best of my knowledge and belief.

David Zieglermeier Date 3/29/24

David M. Zieglermeier, Anoka County Surveyor
 Minnesota License Number 46179

HISTORY OF GOVERNMENT CORNER

Page No. 106

County of Anoka

State of Minnesota

Center Corner of Sec. 27 Township 33 Range 24

CORNER HISTORY:

September 14, 1967 - Set cast iron monument flush in blacktop road using area resurvey. Established ties to monument.

July 3, 1968 - Found cast iron monument and updated ties.

July 26, 1971 - Found cast iron monument and updated ties.

June 30, 1975 - Found cast iron monument and updated ties.

July 11, 1978 - Found cast iron monument and updated ties.

July 21, 1981 - Found cast iron monument and updated ties.

August 6, 1984 - Found cast iron monument and updated ties.

April 4, 1990 - Found cast iron monument and updated ties prior to road construction. Removed monument.

August 24, 1990 - Reset cast iron monument flush on center line after road construction. Updated ties.

January 28, 1992 - Found cast iron monument and updated ties.

May 28, 1997 - Found cast iron monument and updated ties.

June 5, 1997 - Found cast iron monument and updated ties.

December 14, 2020 - Found cast iron monument missing. Set P.K. nail using 3 remaining ties. Occupied P.K. nail using VRS GPS methods.

June 23, 2022 - Found P.K. nail and replaced with a 1/2" iron pipe with Anoka County cap flush with surface. Updated ties and verified position by VRS GPS methods.