

CERTIFICATE OF LOCATION OF GOVERNMENT CORNER

County of Anoka

State of Minnesota



South 1/4 Corner of Sec. 29 Township 33 Range 24

On the 10th day of November, 1965, the described corner was evidenced by a 1" iron pipe from N.C. Hoium ties

and to perpetuate the location of said corner, at the exact location thereof, a permanent marker was placed consisting of a cast iron monument with a sign and post on the North side

AND on the 11th day of December, 2020, said permanent marker was found and the ties were updated. Found sign and post on the north side of monument.

Updated reference ties are as shown below.

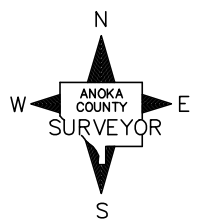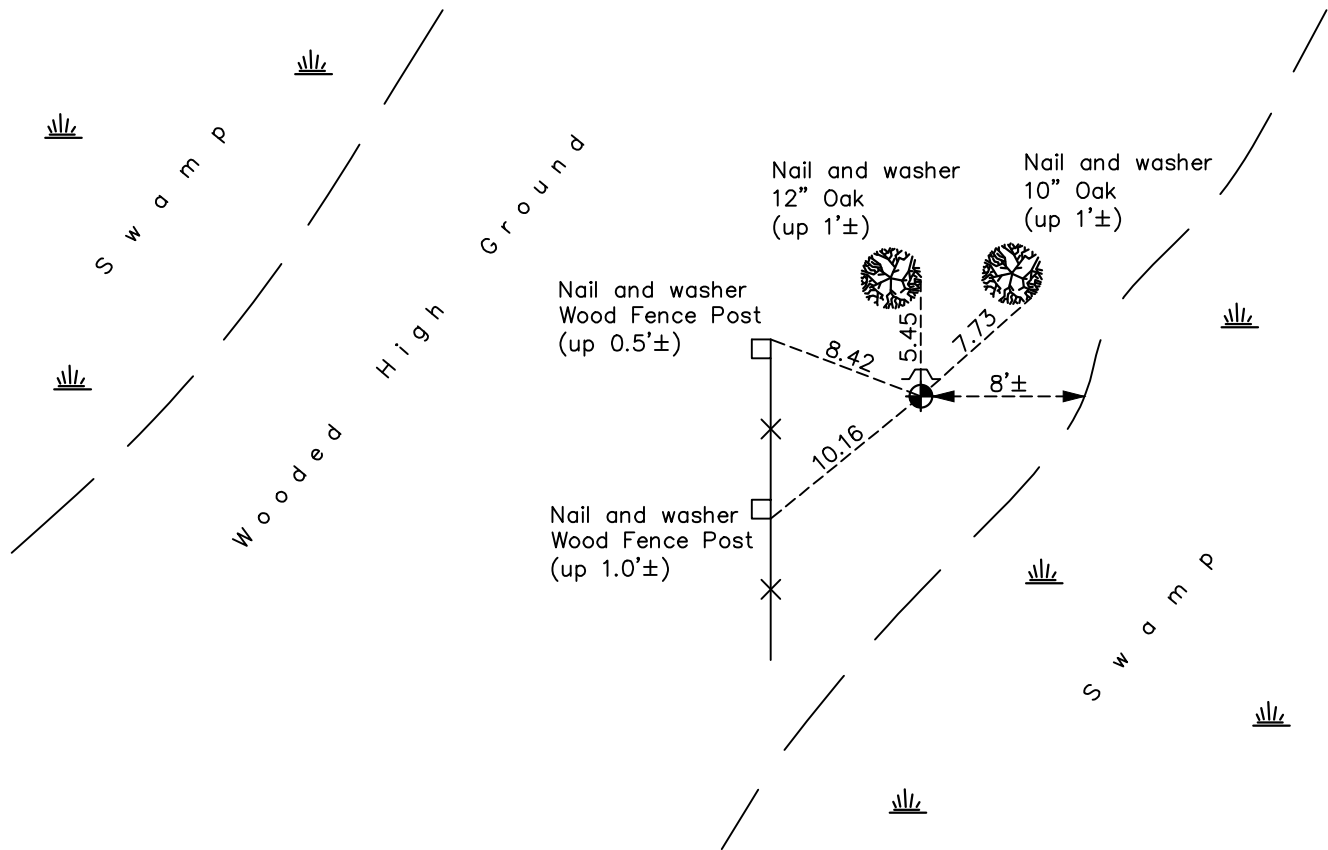

Revision Date
06/25/2021

N.A.D. 1983 Coordinates
(1996 Adjustment)

County Project Coordinates	
Northing	<u>201227.2077</u>
Easting	<u>476619.0236</u>
Date	<u>3/12/02</u>

I hereby certify that this United States public land survey monument record is correct and complete to the best of my knowledge and belief.

David M Zieglmeier Date 7/30/21

David M. Zieglmeier, Anoka County Deputy Surveyor
Minnesota License Number 46179

HISTORY OF GOVERNMENT CORNER

Page No. 119

County of Anoka

State of Minnesota

South 1/4 Corner of Sec. 29 Township 33 Range 24

CORNER HISTORY:

November 29, 1963 - N.C. Hoium found a 1" iron pipe and updated ties.

November 10, 1965 - Found a 1" iron pipe flush using N.C. Hoium's ties. Updated ties.

July 3, 1968 - Found a 1" iron pipe and replaced with a cast iron monument flush. Updated ties.

August 9, 1971 - Found cast iron monument and updated ties.

March 9, 1978 - Reset cast iron monument flush in a new position according to survey by N.C. Hoium October 1966. Updated ties. Set sign and post on the north side.

August 3, 1981 - Found cast iron monument and updated ties.

May 3, 1993 - Found cast iron monument w/sign and post. Updated ties.

July 8, 1997 - Found cast iron monument and updated ties.

March 12, 2002 - Found cast iron monument and updated ties. Established NAD 1983 (1996 adj.) Anoka County project coordinates by static GPS methods.

February 24, 2012 - Found cast iron monument and updated ties.

April 6, 2017 - Found cast iron monument w/sign and post on the north side. Updated ties.

December 11, 2020 - Found cast iron monument w/sign and post on the north side. Updated ties.