

CERTIFICATE OF LOCATION OF GOVERNMENT CORNER

County of Anoka

State of Minnesota


West 1/4 Corner of Sec. 34 Township 33 Range 24

On the 14th day of February, 2024, the described corner was evidenced by a 2" iron pipe

and to perpetuate the location of said corner, at the exact location thereof, a permanent marker was placed consisting of a 2"x 2"x 6' Telspar w/ aluminum cap and punch mark set up 1.0'± in same location replacing found iron pipe laying down, which was removed.

AND on the 14th day of February, 2024, said permanent marker was measured with RTK GPS method to verify newly set location and established ties after setting.

Updated reference ties are as shown below.

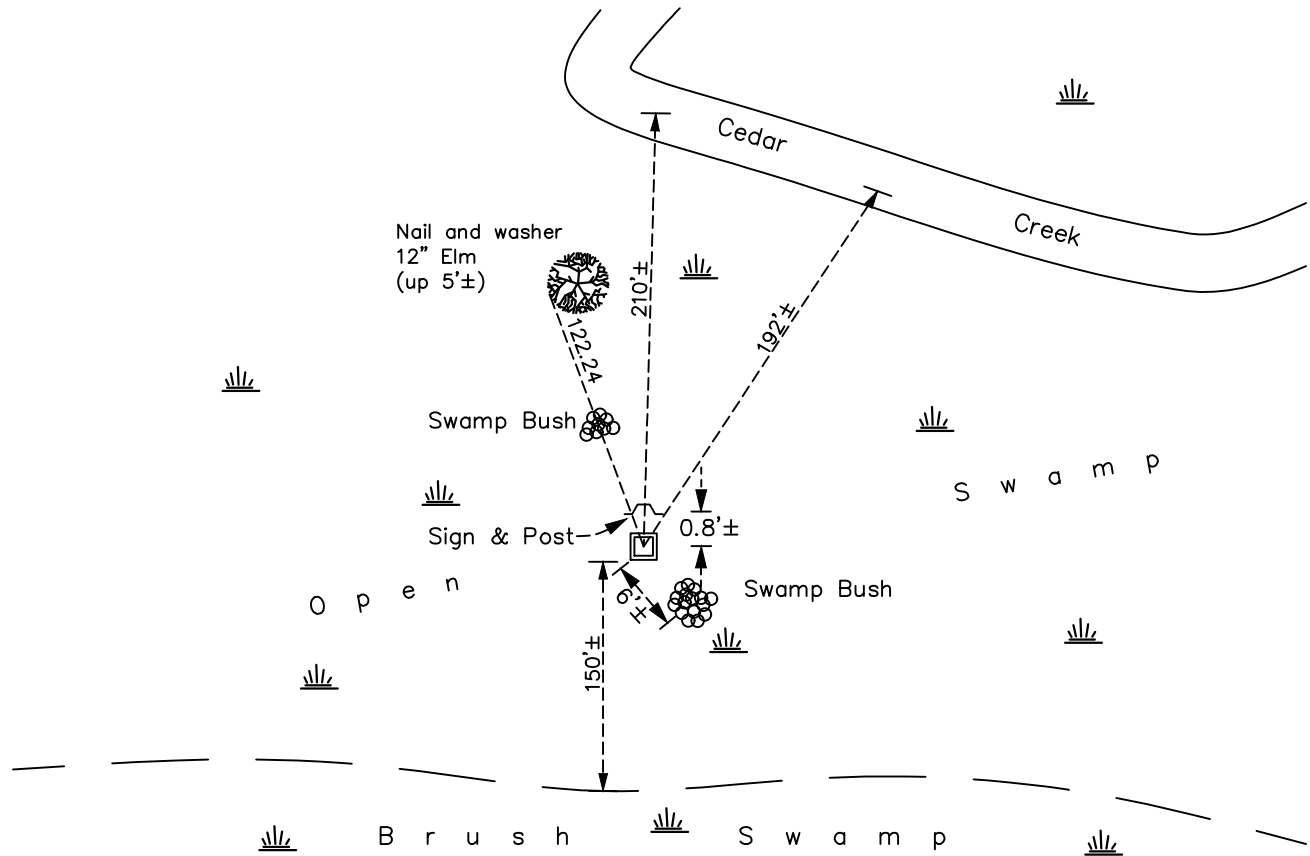

Revision Date

3/27/2024

N.A.D. 1983 Coordinates
(1996 Adjustment)

County Project Coordinates

Northing 198432.5642

Easting 484529.1744

Date 3/6/02

I hereby certify that this United States public land survey monument record is correct and complete to the best of my knowledge and belief.

David Zieglmeier Date 3/28/24

David Zieglmeier Anoka County Surveyor

Minnesota License Number 46179

HISTORY OF GOVERNMENT CORNER

Page No. 124

County of Anoka

State of Minnesota

West 1/4 Corner of Sec. 34 Township 33 Range 24

CORNER HISTORY:

May 1855 - This corner was established by James M. Marsh, Deputy Surveyor. Marsh marked this position by "set quarter section post" with one bearing tree marked as an accessory. Distance of 40.00 chains north of SW Corner Section 34 and 40.00 chains south of NW Corner Section 34.

March 7, 1977 - Set red and white iron pipe up 3'± w/sign using area resurvey. Established ties to pipe.

July 14, 1992 - Found red and white iron pipe and updated ties.

March 6, 2002 - Found red and white iron pipe. Established NAD 1983 (1996 adj.) Anoka County project coordinates by static GPS methods.

February 14, 2024 - Found iron pipe laying down, buried in ground and vegetation, to southeast; removed. Replaced with 2"x 2"x 6' Telspar with 'County Surveyor' cap and punch mark, set up 1'±. Set to published coordinates using RTK GPS method. No historical ties available. Established new ties after setting. Added sign and post to north side. Job #24-100