

CERTIFICATE OF LOCATION OF GOVERNMENT CORNER

County of Anoka

State of Minnesota


SOUTH 1/4 Corner of Sec. 20 Township 32 Range 25

I hereby certify that on the 19TH day of JUNE, 1964, I found the described corner which was evidenced by CONCRETE MONUMENT

and I further certify that to perpetuate the location of said corner, I did, at the exact location thereof, place a permanent marker consisting of CAST IRON MONUMENT (DOWN 0.8)


~~SIGN & POST ON EAST SIDE~~ SIGN & POST ON NORTH SIDE

which reference or witness monuments are located in the manner following:

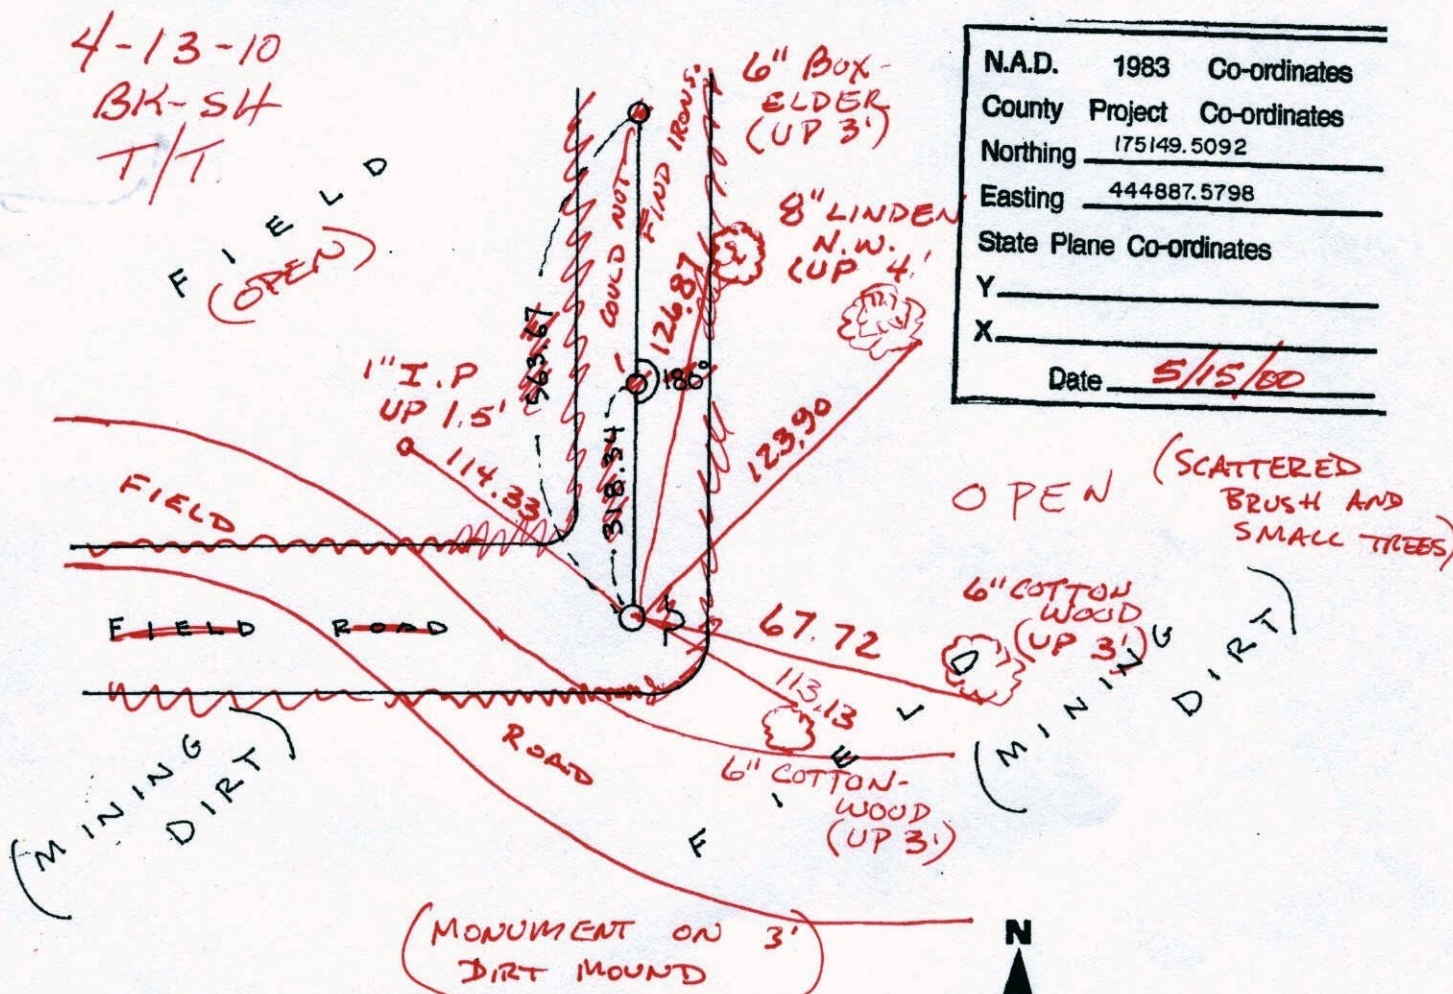

N.A.D.	1983	Co-ordinates
County	Project	Co-ordinates
Northing	175149.5092	
Easting	444887.5798	
State Plane Co-ordinates		
Y	_____	
X	_____	
Date	5/15/00	

Revised date	Revised date	Revised date
8 13 82		
7 28 85		
6 27 88		
4 26 93		
8 9 93		
5 15 00		

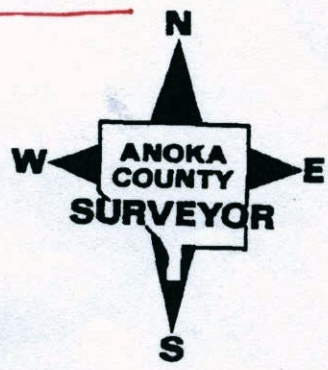

CERTIFICATE OF LOCATION OF GOVERNMENT CORNER

County of Anoka


State of Minnesota

SOUTH 1/4 Corner of Sec. 20 Township 32 Range 25

I hereby certify that on the 19TH day of JUNE, 1964, I found the described corner which was evidenced by CONCRETE MONUMENT

and I further certify that to perpetuate the location of said corner, I did, at the exact location thereof, place a permanent marker consisting of CAST IRON MONUMENT
SIGN & POST ON EAST SIDE

which reference or witness monuments are located in the manner following:

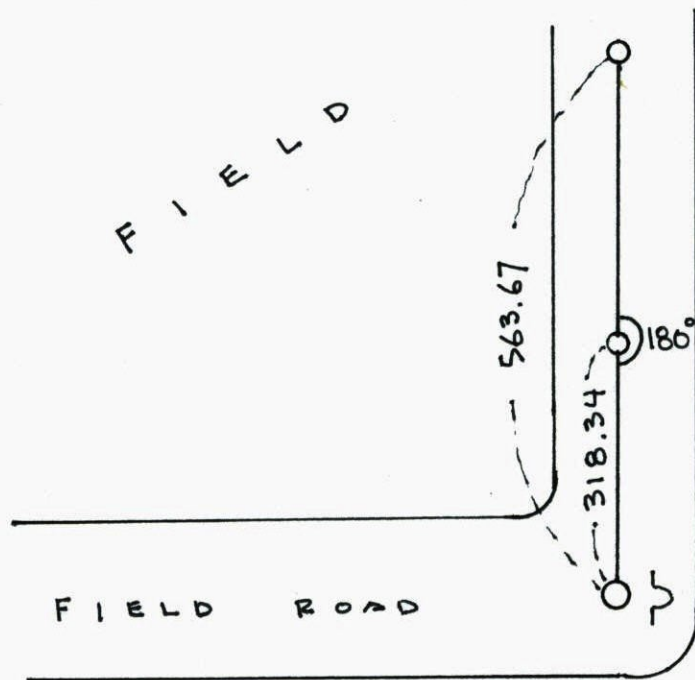


N.A.D.	1983	Co-ordinates
County	Project	Co-ordinates
Northing	<u>175149.5092</u>	
Easting	<u>444887.5798</u>	
State Plane Co-ordinates		
Y	_____	
X	_____	
Date	_____	

(MINING DIRT)


FIELD (MINING DIRT)

Revised date	Revised date	Revised date
8 13 82		
7 28 85		
6 27 88		
4 26 93		
8 9 93		
5 15 00		

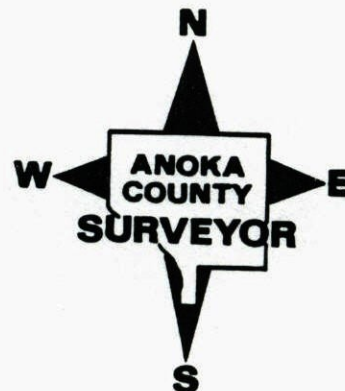

SOUTH 1/4 COR. SEC. 20 T 32 R 25

GPS & TRANSIT TIE ON CAST IRON
MONUMENT WITH SIGN & POST E. SIDE
(MINING DIRT THROUGHOUT)

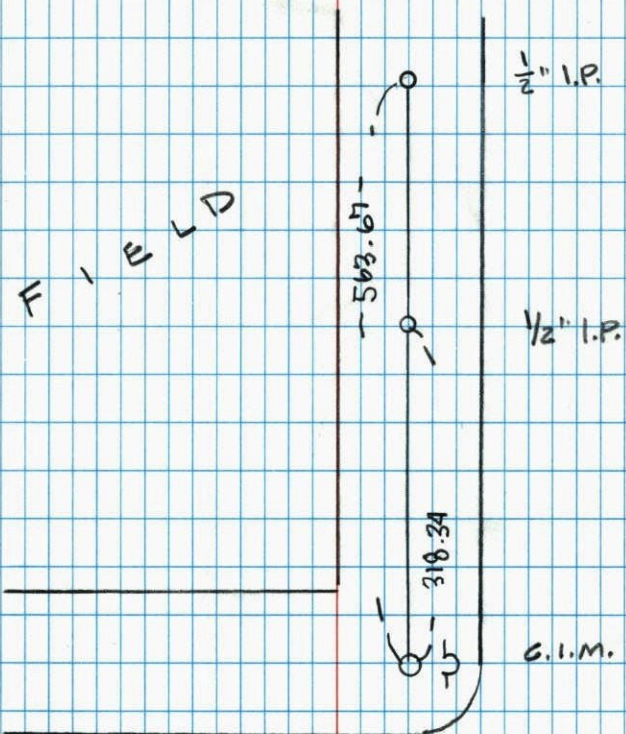


5/15/00
J. SIMMER
T. SCHWAB
B. KLEMMZ

S 1/4 CORNER SECTION 20 T 32 R 25

RETIED CAST IRON AFTER FIRE
DESTROYED TREES


G.I. DOWN 1' SIGN & POST ON SOUTH
SIDE

4-26-93
H. CARSON
B. KLEMMZ
M. STEWART

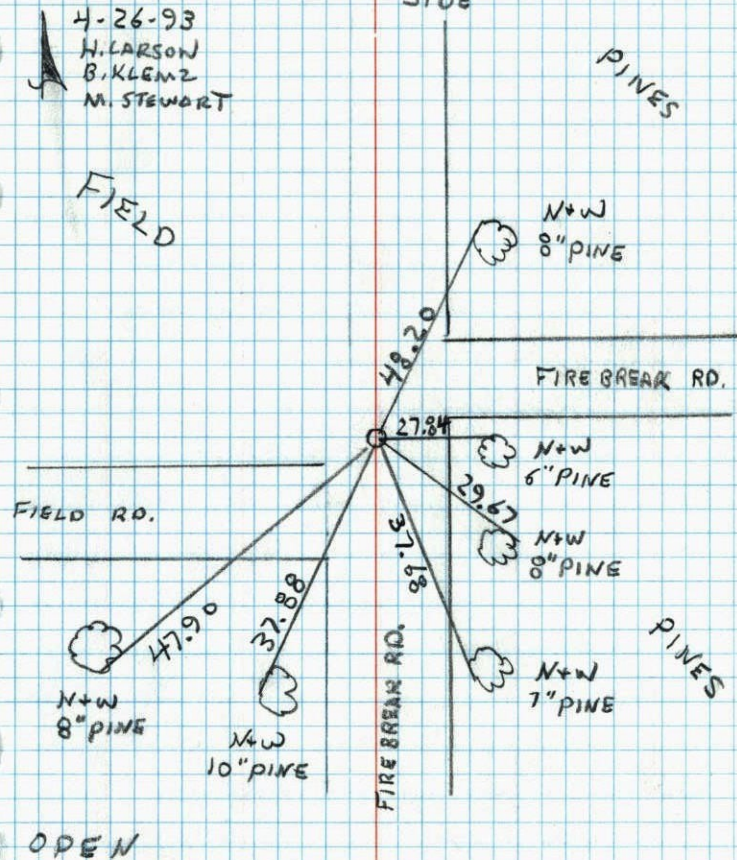

S 1/4 Cor Sec 20 T32 R25

RETIED CAST IRON MONUMENT

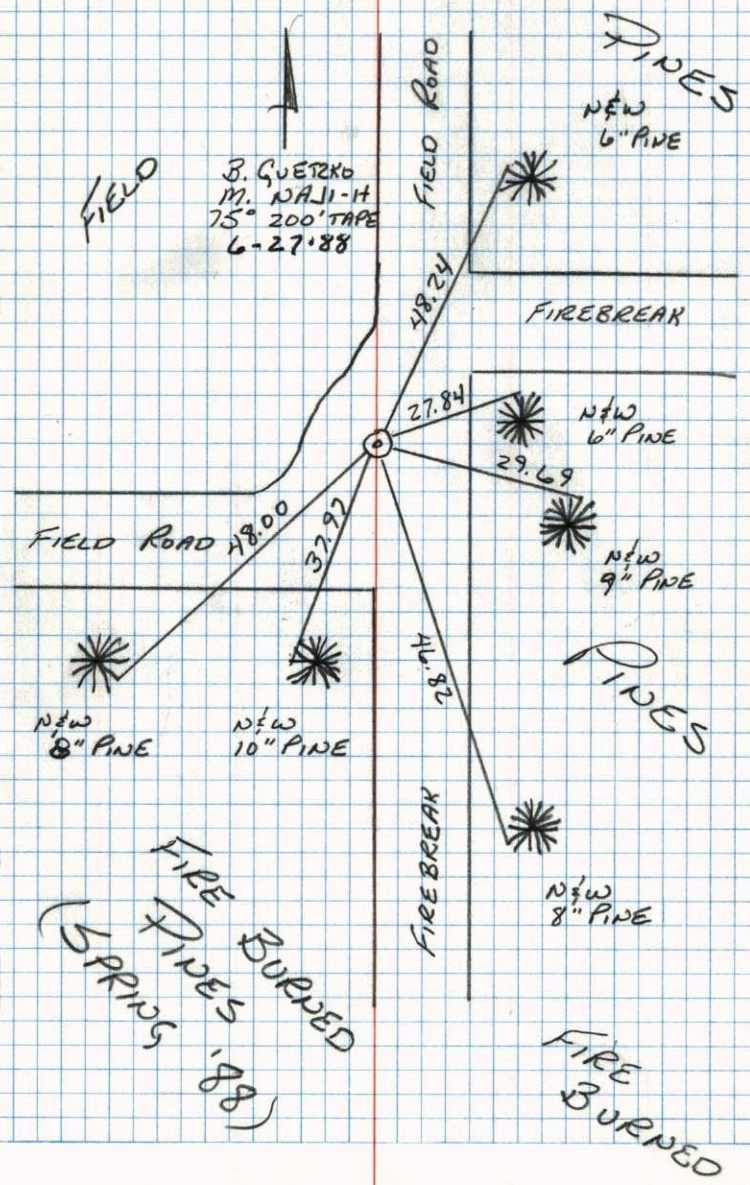

B. GUETZKO
M. NAJJI-H
75' 200' TAPE
6-27-88

NW 8\"/>

FIRE BURPED
PINES
(SPRING '88)


FIRE BURPED

NO. 448 TELEPHONE

S 1/4 Cor. Sec. 20, T32, R 25

Found 4" Sq. Conc. Mon. down 0.5' with top broken off. Straightened up and tied. Set Cast Iron Mon down 0.5', 3/4" Iron Pipe on East side. Sign Post on South side.

N 19 June 64
J. Oliver
N. Livgard
J. Dunlap

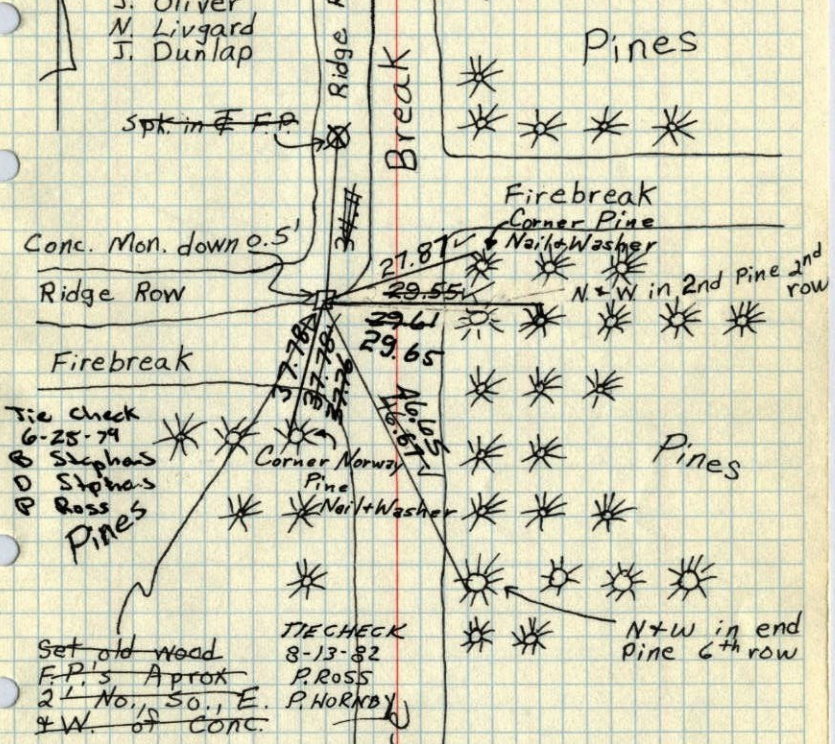

Tie check
B. Stephens
S. Ross
Pines

Set old wood
F.P.'s Approx
2' No. 15 So., E.
NW. of CONC.

Tie Check
June 20, 1969
D. Powell
R. Olson 7-7-76
B. Olson
Tie Check July 18, 1972
B. Olson
J. Boettcher
D. Brien


TEMPERATURE CORRECTED
AND HORIZONTALLY
TAPED MEASUREMENTS

ROLAND W. ANDERSON
COUNTY SURVEYOR
ANOKA COUNTY, MINNESOTA

S 1/4 Cor. Sec. 20, T32, R 25

Found 4" Sq. Conc. Mon. down 0.5' with top broken off. Straightened up and tied.

N 19 June 64
J. Oliver
N. Livgard
J. Dunlap

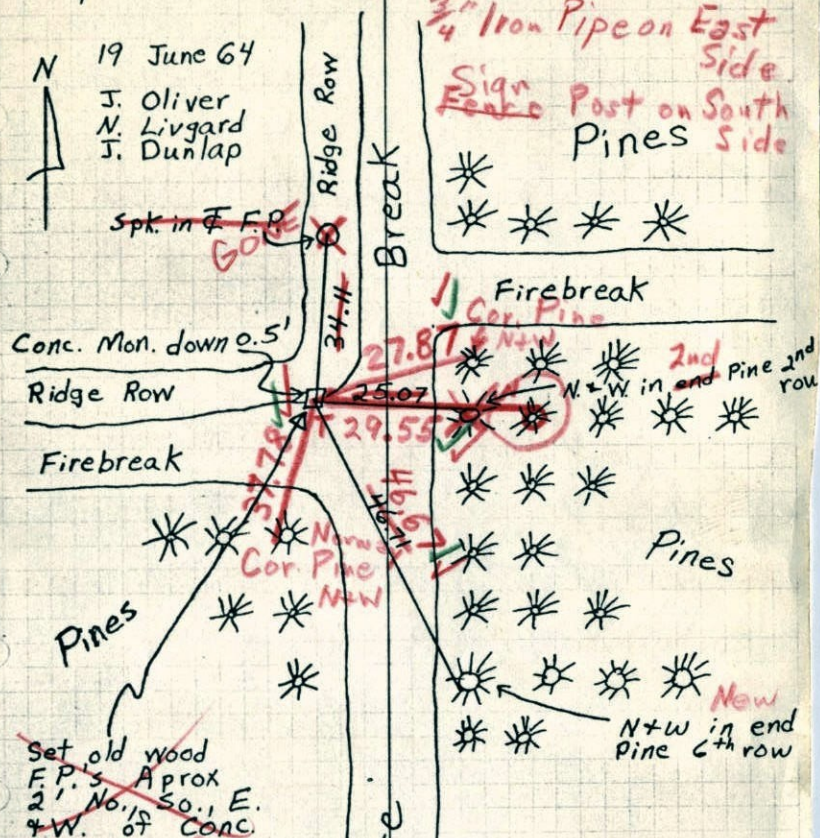

Set old wood
F.P.'s Approx
2' No., So., E.
+ W. of Conc.

6/20/69
#6-60°
D. Powell
R. Olson
B. Olson

TEMPERATURE CORRECTED
AND HORIZONTALLY
TAPED MEASUREMENTS


ROLAND W. ANDERSON
COUNTY SURVEYOR
ANOKA COUNTY, MINNESOTA

S 1/4 Cor. Sec. 20, T32, R25

Found 4" Sq. Conc. Mon down 0.5'

with top broken off. Straightened up and tied.

N 19 June 64
680 #2
J. Oliver
N. Livgard
J. Dunlap

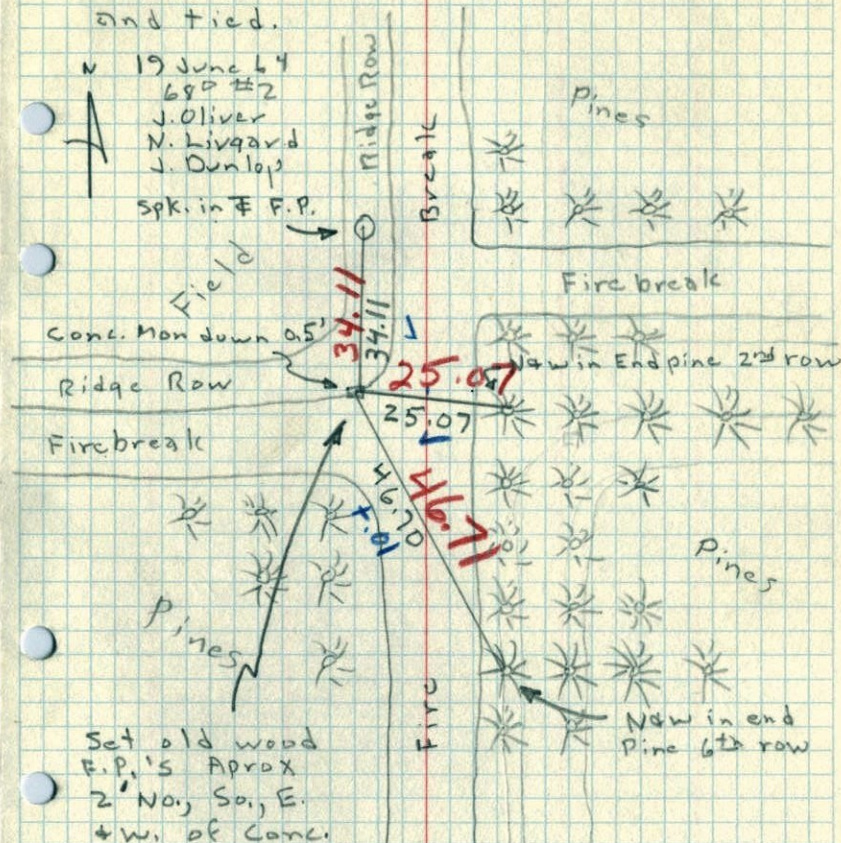

Set old wood
F.P.'s Approx
2' No., So., E.
+ W. of Conc.

NW in end
Pine 6th row