

CERTIFICATE OF LOCATION OF GOVERNMENT CORNER

County of Anoka


State of Minnesota

WITNESS TO MEANDER Corner of Sec. 36 Township 32 Range 25
ON THE SOUTH LINE


I hereby certify that on the 1ST day of JULY, 19 63, I found the described corner which was evidenced by AREA RESURVEY

and I further certify that to perpetuate the location of said corner, I did, at the exact location thereof, place a permanent marker consisting of CAST IRON MONUMENT WITH SIGN AND POST
ON THE NORTH SIDE

Anoka Co. which reference or witness monuments are located in the manner following:

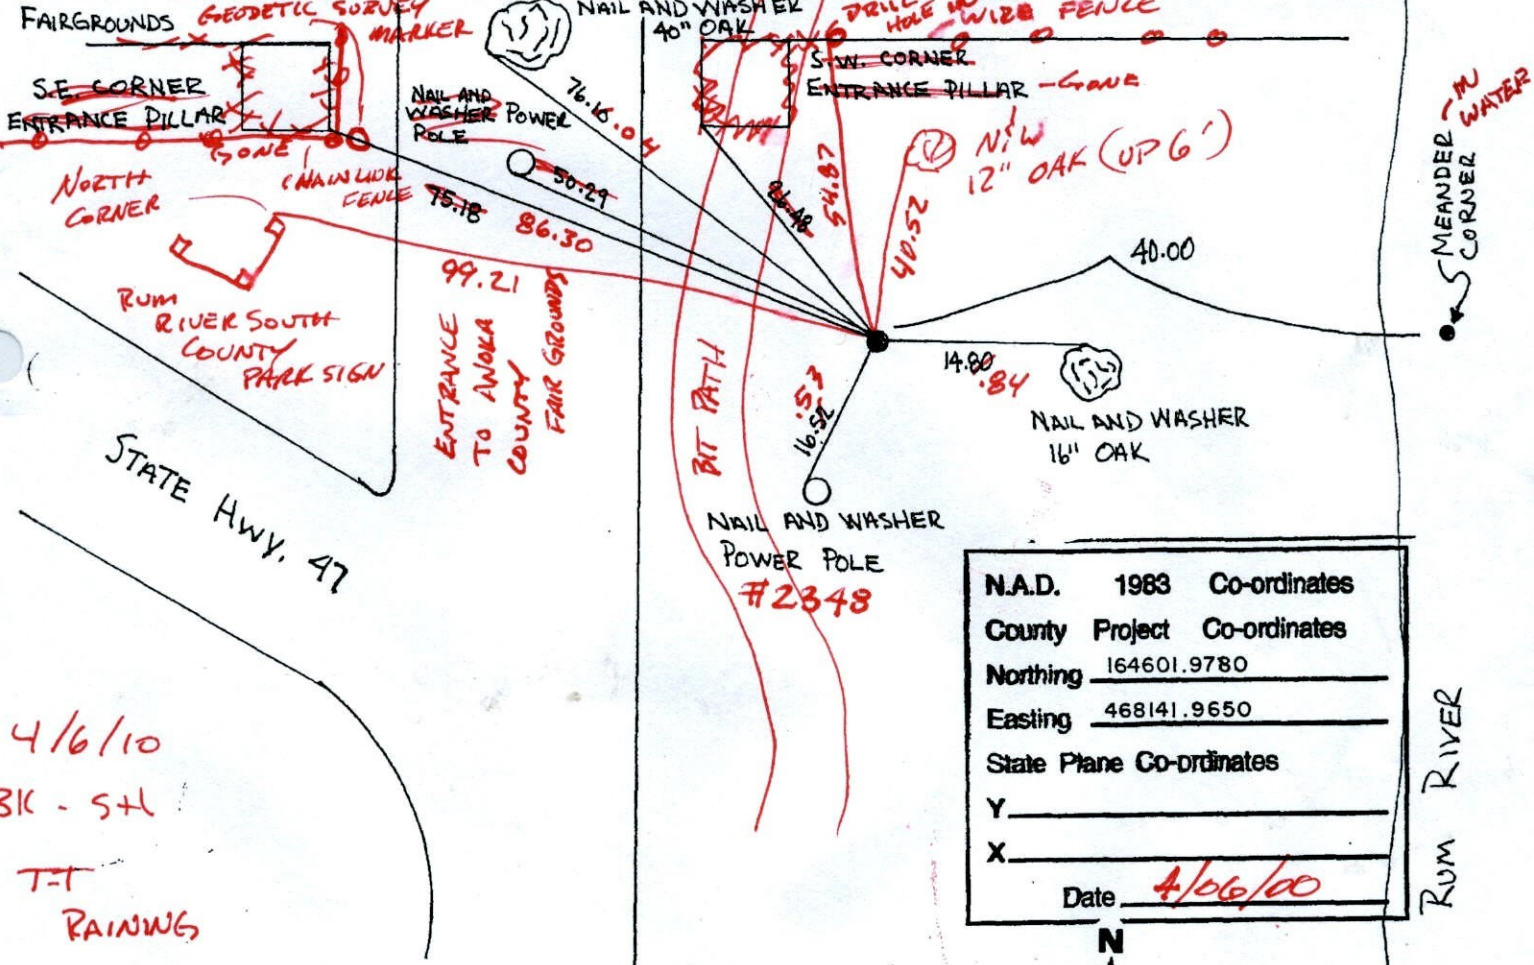

N.A.D.	1983	Co-ordinates
County	Project	Co-ordinates
Northing		<u>164601.9780</u>
Easting		<u>468141.9650</u>
State Plane Co-ordinates		
Y		_____
X		_____
Date		<u>4/06/00</u>

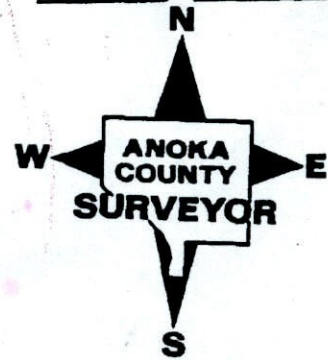

Revised date	Revised date	Revised date
<u>8-17-82</u>		
<u>7-17-85</u>		
<u>6-29-88</u>		
<u>8-11-93</u>		
<u>4-6-00</u>		

4/6/10
BK - STL
T-T
RAINWG

RUM RIVER
MEANDER CORNER
WATER

CERTIFICATE OF LOCATION OF GOVERNMENT CORNER

County of Anoka


State of Minnesota

WITNESS TO MEANDER Corner of Sec. 36 Township 32 Range 25
ON THE SOUTH LINE

I hereby certify that on the 1ST day of JULY, 19 63, I found the described corner which was evidenced by AREA RESURVEY


and I further certify that to perpetuate the location of said corner, I did, at the exact location thereof, place a permanent marker consisting of CAST IRON MONUMENT WITH SIGN AND POST
ON THE NORTH SIDE

Anoka Co. which reference or witness monuments are located in the manner following:

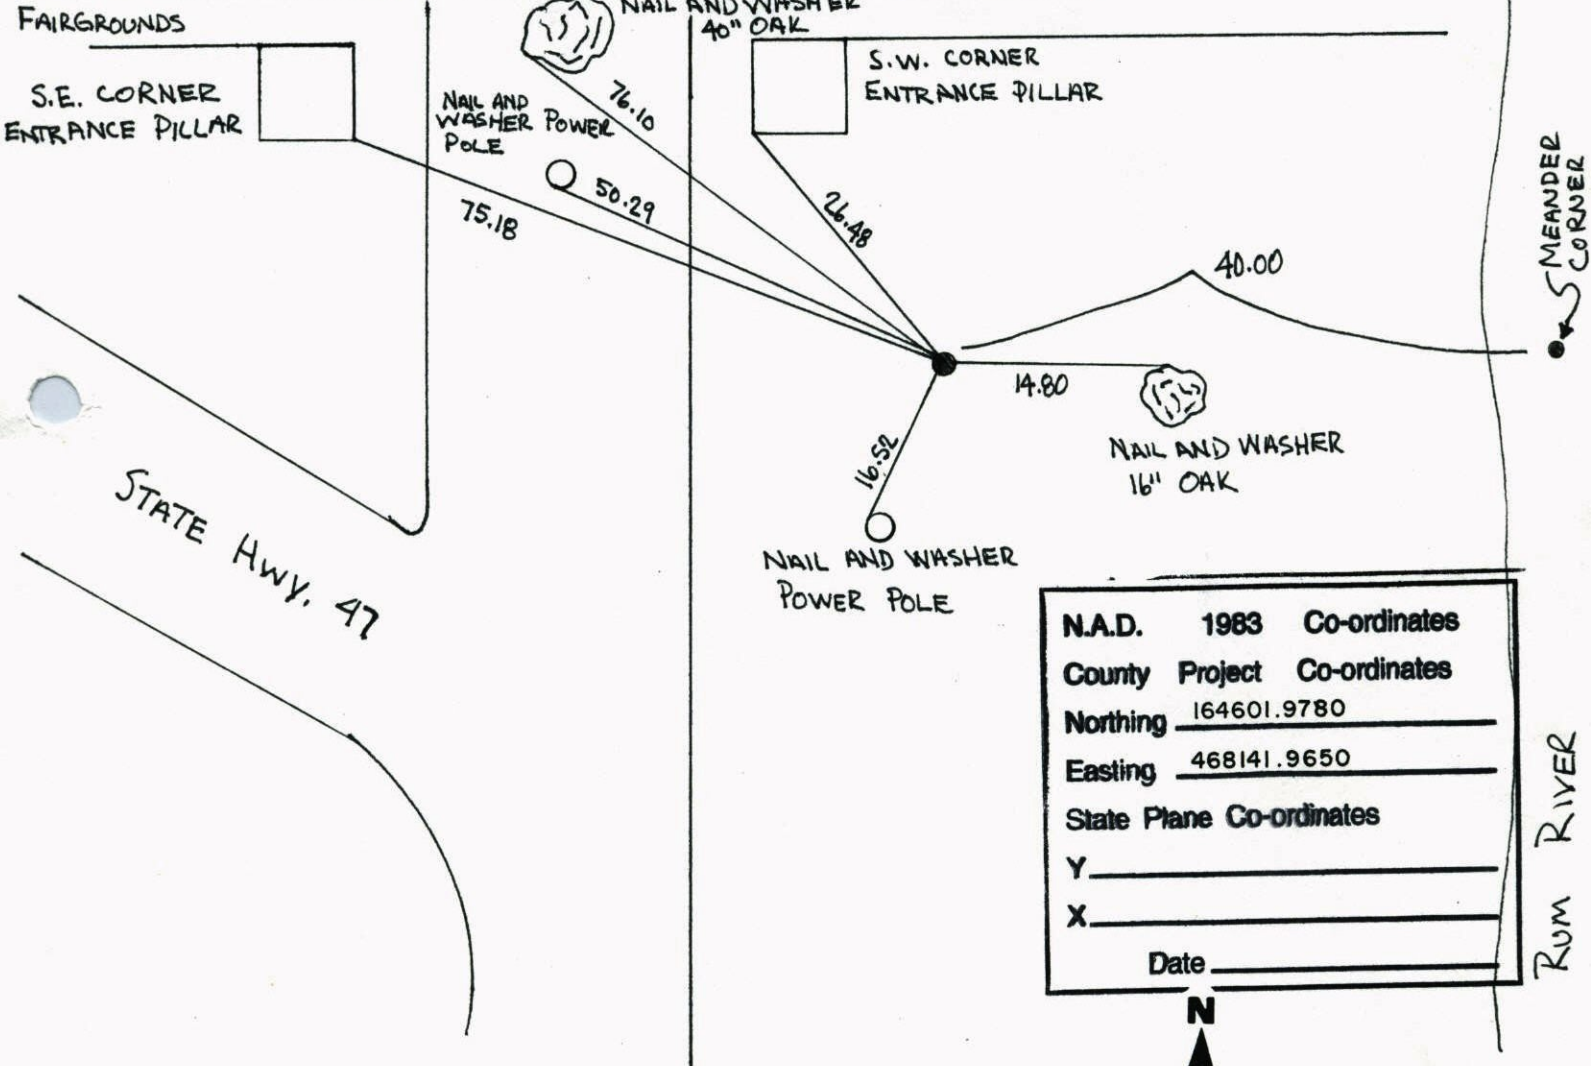

N.A.D.	1983	Co-ordinates
County	Project	Co-ordinates
Northing		<u>164601.9780</u>
Easting		<u>468141.9650</u>
State Plane Co-ordinates		
Y		_____
X		_____
Date _____		


Revised date	Revised date	Revised date
<u>8-17-82</u>		
<u>7-17-85</u>		
<u>6-29-88</u>		
<u>8-11-93</u>		
<u>4-6-00</u>		

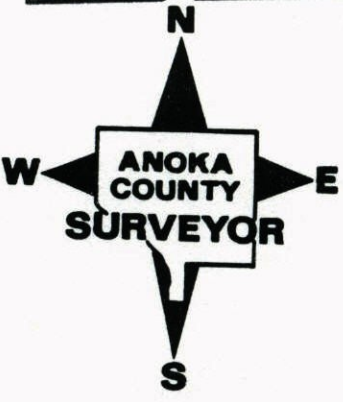

WITNESS TO MEANDER COR. ON S. LINE

SEC. 36, T. 32, R. 25 - RETIED C.I.M.

DURING G.P.S.

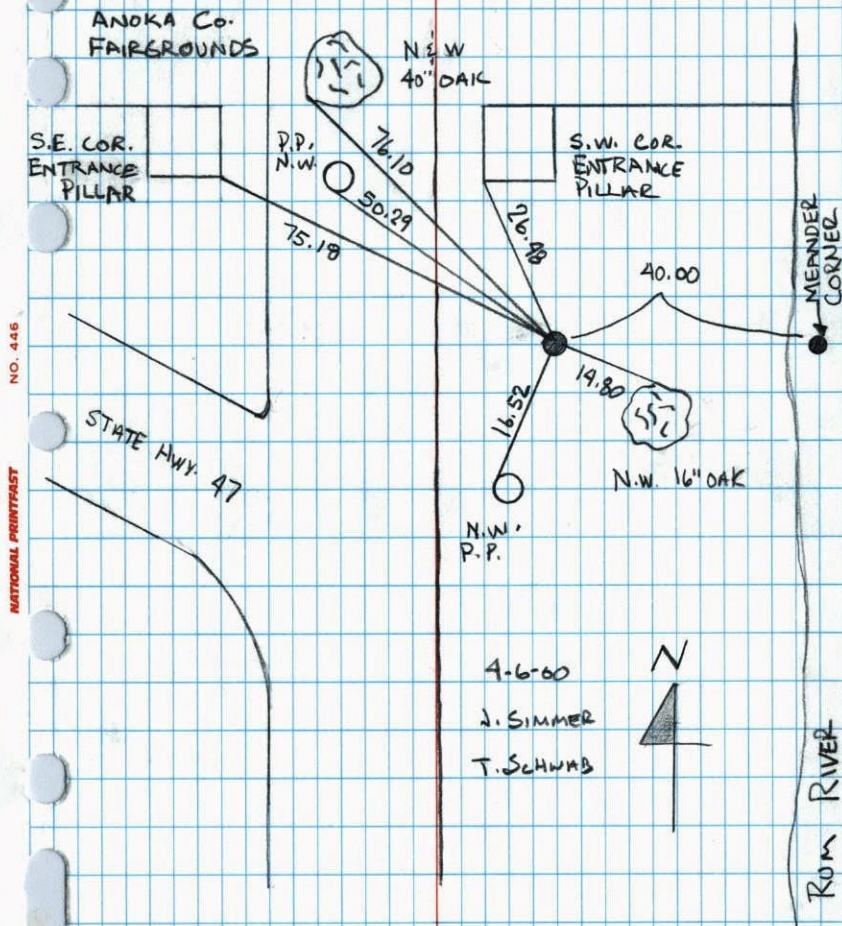


WITNESS CORNER TO MEANDER CORNER

ON THE SOUTH LINE SEC 36 T32 R25


RETIED CAST IRON MONUMENT

ANOKA COUNTY FAIRGROUNDS

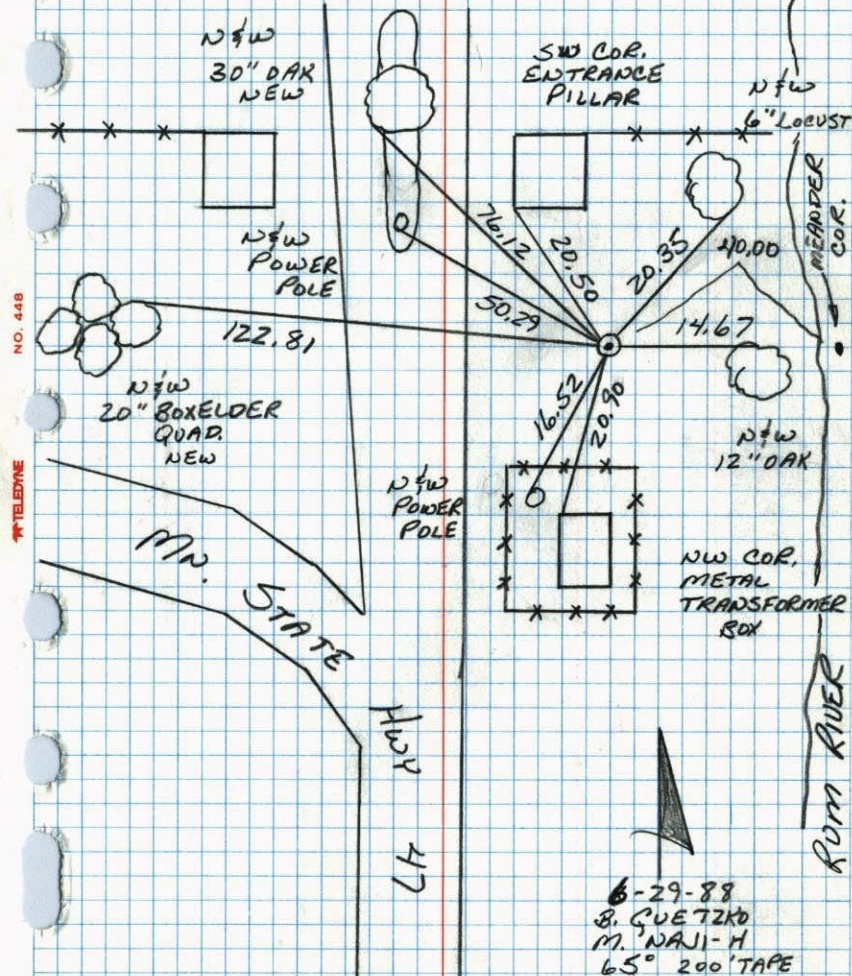

Witness to M.C. on So. line Sec. 36, T. 32, R. 25
Set cast from mon. from resurvey

TIE CHECK Tie Check
8-17-82 June 23 1969
P. ROSS D. Powell
P. HORNBY R. Olson
B. Olson

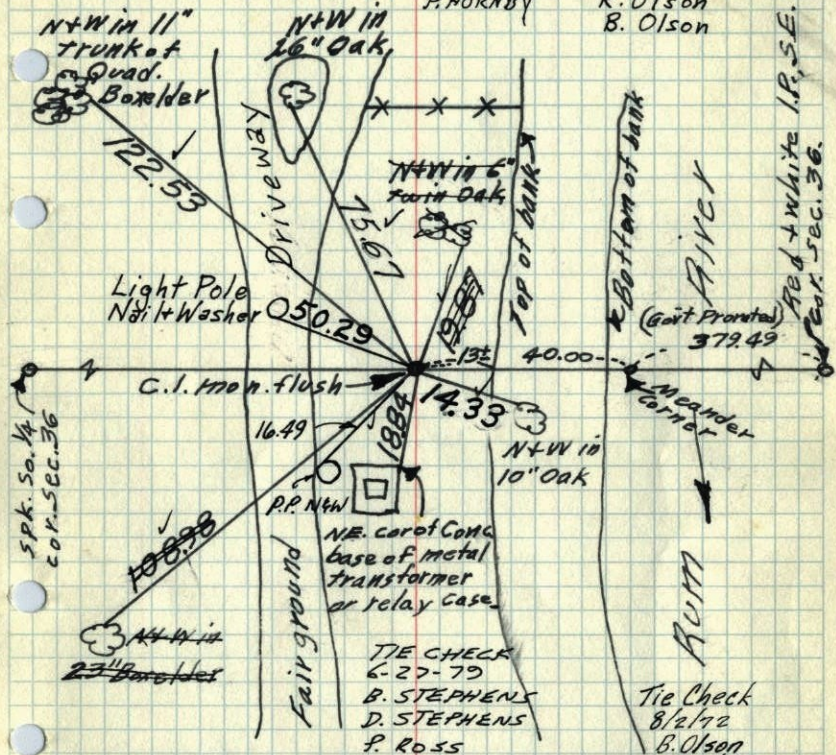

TIE CHECK
6-27-79
B. STEPHENS
D. STEPHENS
P. ROSS

Tie Check
8/2/72
B. Olson
J. Boetche

TEMPERATURE CORRECTED
AND HORIZONTALLY
TAPED MEASUREMENTS

1 July 63
J. Oliver
P. Carlson


Retie 8/12/64

M. D. Anderson
J. Dunlop
TIE CHECK
7-12-76
G. ADAMS
D. DANL
B. BRIEN

ROLAND W. ANDERSON
COUNTY SURVEYOR
ANOKA COUNTY, MINNESOTA.

Witness to M.C. on So. line Sec. 36, T. 32, R. 25
Set cast from mon. from resurvey

6/23/69
#4-68°V
D. Powell
R. Olson
B. Olson

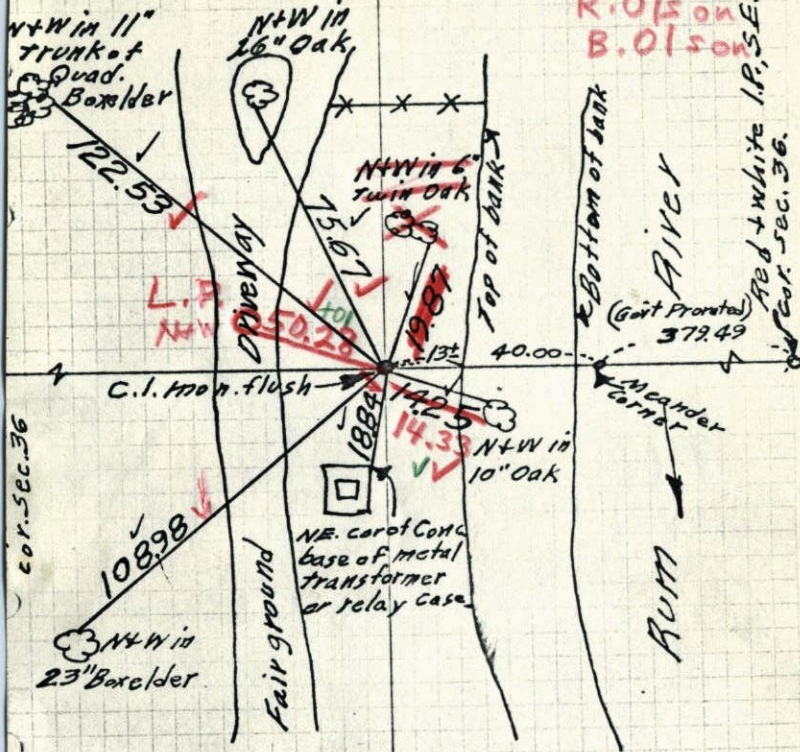

TEMPERATURE CORRECTED
AND HORIZONTALLY
TAPED MEASUREMENTS

1 July 63
J. Oliver
P. Carlson

Retie 8/12/64

M. D. Anderson
J. Dunlop

ROLAND W. ANDERSON
COUNTY SURVEYOR
ANOKA COUNTY, MINNESOTA

