

# CERTIFICATE OF LOCATION OF GOVERNMENT CORNER

County of Anoka

State of Minnesota


## North $\frac{1}{4}$ Corner of Sec. 2 Township 32 Range 25

On the 12th day of August, 1960, the described corner was evidenced by a granite monument with an iron pipe on the north side

and to perpetuate the location of said corner, at the exact location thereof, a permanent marker was placed consisting of the same granite monument leaning South (ties were measured to the leaning position)

AND on the 20th day of October, 2022, said permanent marker was found down 0.3' and leaning South in a triangular shaped buried tire. Updated ties (center mark no longer defined)

Updated reference ties are as shown below.

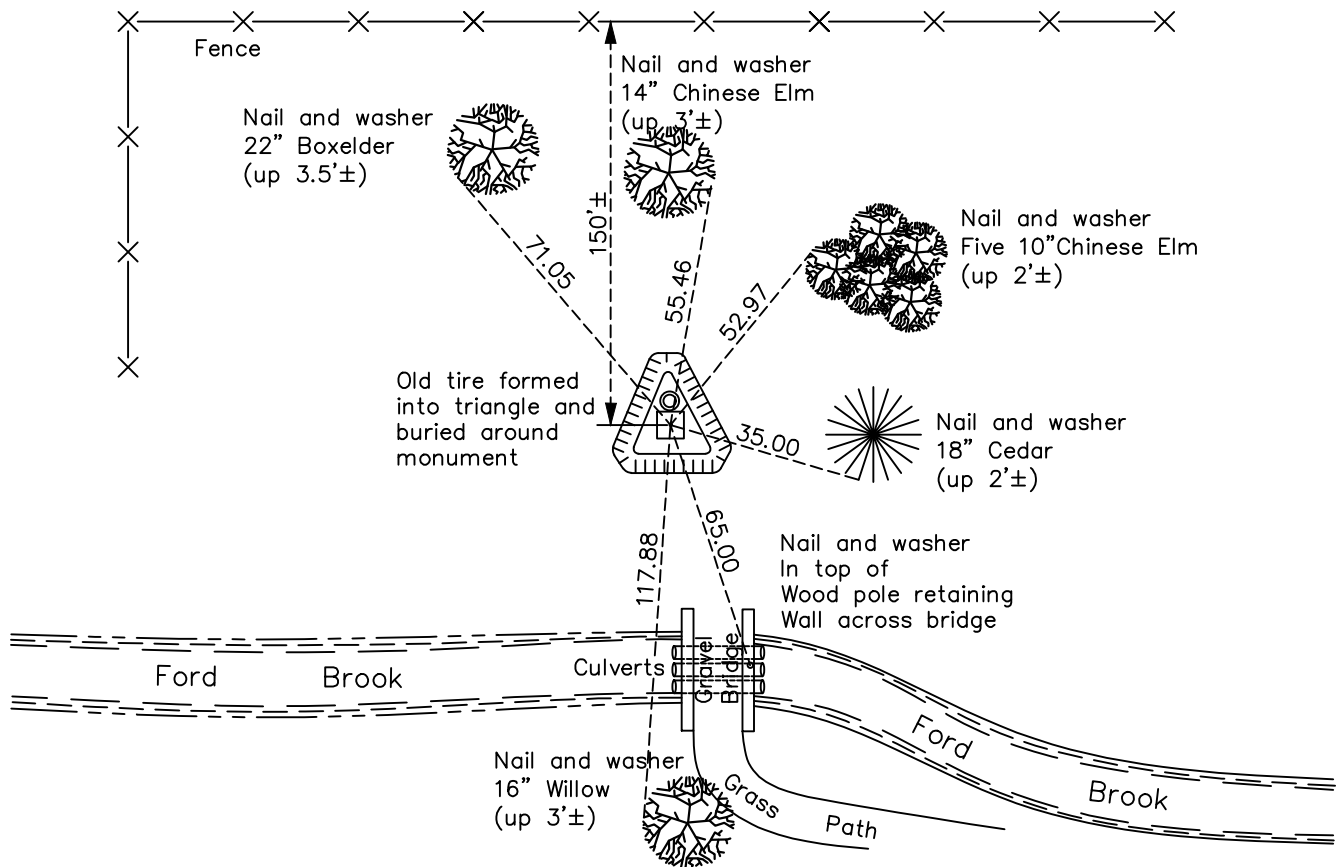

Revision Date  
12/21/2022

N.A.D. 1983 Coordinates  
(1996 Adjustment)

County Project Coordinates	
Northing	<u>196234.9786</u>
Easting	<u>460811.8544</u>
Date	<u>2/28/00</u>

I hereby certify that this United States public land survey monument record is correct and complete to the best of my knowledge and belief.

*David Zieglmeier* Date 2/22/23

David Zieglmeier Anoka County Surveyor  
Minnesota License Number 46179

# HISTORY OF GOVERNMENT CORNER

Page No. 5

County of Anoka

State of Minnesota

## North 1/4 Corner of Sec. 2 Township 32 Range 25

### **CORNER HISTORY:**

**March 23, 1948** - Jackson found granite monument with an iron pipe on the north side and established ties to monument.

**August 12, 1960** - Found granite monument flush with the surface and with an iron pipe on the north side. Updated ties.

**August 10, 1964** - Found granite monument with an iron pipe on the north side and updated ties.

**June 9, 1969** - Found granite monument with an iron pipe on the north side and updated ties.

**July 19, 1972** - Found granite monument with an iron pipe on the north side and updated ties.

**June 18, 1976** - Found granite monument with an iron pipe on the north side and updated ties.

**June 27, 1979** - Found granite monument with an iron pipe on the north side and updated ties.

**August 18, 1982** - Found granite monument with an iron pipe on the north side and updated ties.

**July 30, 1985** - Found granite monument with an iron pipe on the north side and updated ties.

**July 5, 1988** - Found granite monument with an iron pipe on the north side and updated ties. Monument is leaning north but fit existing ties.

**August 23, 1993** - Found granite monument with an iron pipe on the north side and updated ties to leaning position.

February 28, 2000 – Found granite monument with an iron pipe on the north side and established NAD 1983 (1996 Adjustment) Anoka County Project Coordinates by Static GPS methods to leaning position. Updated ties to leaning position.

**June 1, 2010** - Found granite monument down 0.3'± with an iron pipe on the north side inside a tire triangle and leaning south. Updated ties to leaning position.

**September 28, 2015** - Found granite monument down 0.3'± with an iron pipe on the north side inside a triangular shaped buried tire and leaning south. Updated ties to leaning position.

**June 11, 2020** - Found granite monument down 0.3'± with an iron pipe on the north side inside a triangular shaped buried tire and leaning south. Updated ties to leaning position.

# HISTORY OF GOVERNMENT CORNER

Page No. 5

County of Anoka

State of Minnesota

North 1/4 Corner of Sec. 2 Township 32 Range 25

## **CORNER HISTORY:**

October 20, 2022 - Found granite monument down 0.3'± with an iron pipe on the north side inside a triangular shaped buried tire and leaning south. Verified position by VRS GPS method and updated ties.