

CERTIFICATE OF LOCATION OF GOVERNMENT CORNER

County of Anoka

State of Minnesota


East 1/4 Corner of Sec. 1 Township 32 Range 25

On the 2nd day of November, 1998, the described corner was evidenced by a cast iron monument

and to perpetuate the location of said corner, at the exact location thereof, a permanent marker was placed consisting of a 1/2" iron pipe in concrete apron with blacktop overlay

AND on the 18th day of October, 2022, said permanent marker was found in blacktop on centerline and the ties were updated

Updated reference ties are as shown below.

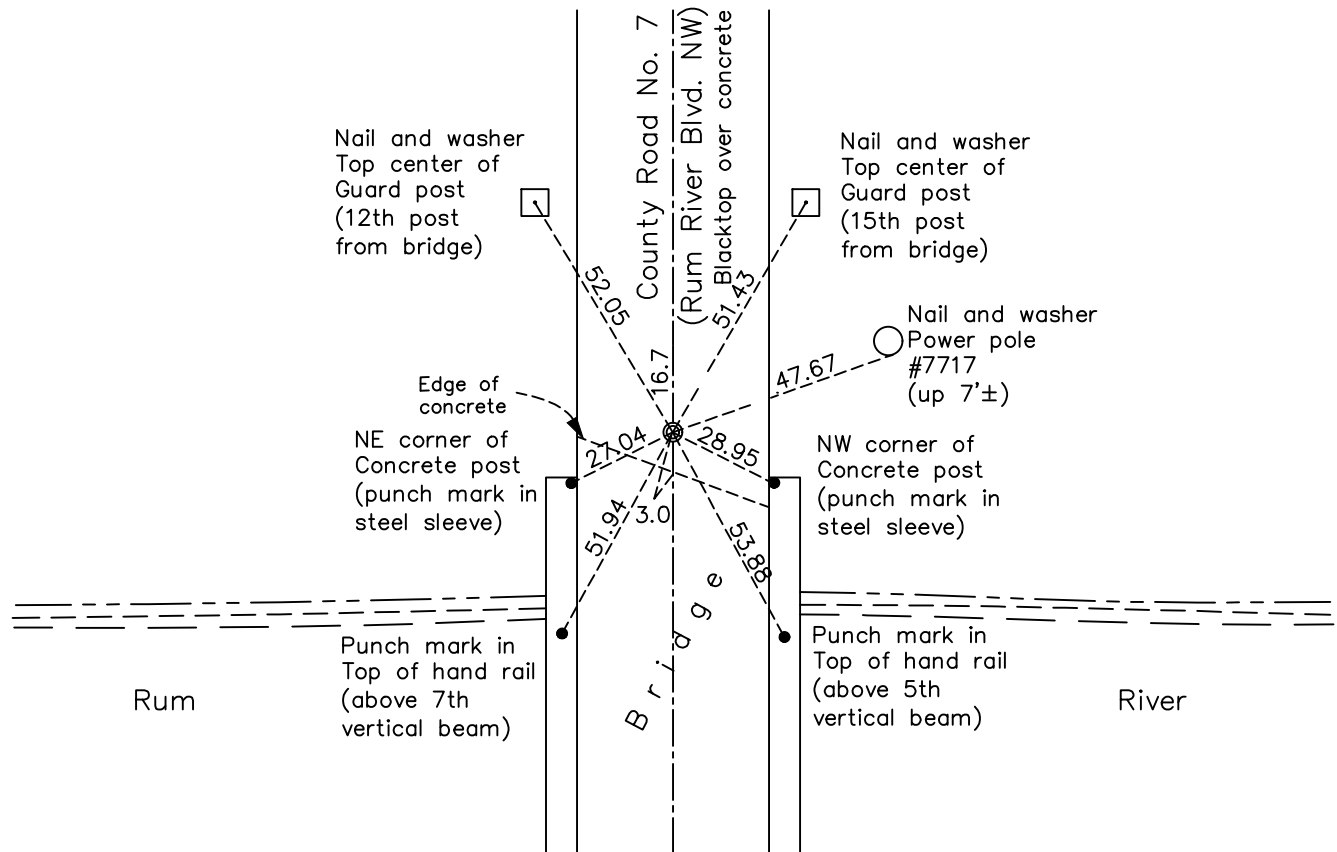

Revision Date
12/21/2022

N.A.D. 1983 Coordinates
 (1996 Adjustment)

County Project Coordinates	
Northing	<u>193518.4714</u>
Easting	<u>468639.1615</u>
Date	<u>1/04/00</u>

I hereby certify that this United States public land survey monument record is correct and complete to the best of my knowledge and belief.
David Zieglmeier Date 2/22/23
 David Zieglmeier Anoka County Surveyor
 Minnesota License Number 46179

HISTORY OF GOVERNMENT CORNER

Page No. 21

County of Anoka

State of Minnesota

East 1/4 Corner of Sec. 1 Township 32 Range 25

CORNER HISTORY:

December 15, 1965 - Set P.K. nail using area resurvey and established ties to monument. Set P.K. nails 2.00' north and east of corner location.

May 27, 1966 – Replaced P.K. nail with a cast iron monument and updated ties.

June 9, 1969 – Found cast iron monument and updated ties.

August 21, 1972 – Found cast iron monument and updated ties.

June 22, 1977 – Replaced cast iron monument with a P.K. nail during road construction and updated ties.

October 2, 1978 – Replaced P.K. nail with a cast iron monument set flush with the surface and on centerline of road after road construction. Set P.K. nails 2.00' north and east of monument and updated ties.

June 15, 1979 – Found cast iron monument and updated ties.

August 18, 1982 – Found cast iron monument and updated ties.

July 3, 1984 – Raised cast iron monument and updated ties.

July 23, 1985 – Found cast iron monument and updated ties.

July 13, 1988 – Found cast iron monument and updated ties.

August 6, 1989 – Found cast iron monument and updated ties.

August 30, 1990 – Found cast iron monument and updated ties.

August 9, 1993 – Found cast iron monument and updated ties.

September 8, 1994 – Found cast iron monument and updated ties.

June 24, 1998 – Set construction ties and removed cast iron monument prior to road construction.

November 2, 1998 – Set 1/2" iron pipe in concrete bridge apron after road construction using construction ties and updated ties.

January 4, 2000 – Found 1/2" iron pipe in concrete apron and established NAD 1983 (1996 Adjustment) Anoka County Project Coordinates by Static GPS methods. Updated ties.

May 14, 2010 – Found 1/2" iron pipe in concrete apron on centerline and updated ties.

HISTORY OF GOVERNMENT CORNER

Page No. 21

County of Anoka

State of Minnesota

East 1/4 Corner of Sec. 1 Township 32 Range 25

CORNER HISTORY:

July 27, 2015 - Found 1/2" iron pipe in concrete apron under blacktop overlay and on centerline. Verified location of monument by VRS GPS method and updated ties.

March 12, 2020 - Found 1/2" iron pipe in concrete apron under blacktop overlay and on centerline. Verified location of corner by VRS GPS methods and updated ties.

October 18, 2022 – Found 1/2" iron pipe in blacktop, verified location of corner by VRS GPS method and updated the ties.