

CERTIFICATE OF LOCATION OF GOVERNMENT CORNER

County of Anoka

State of Minnesota


West 1/4 Corner of Sec. 13 Township 32 Range 25

On the 29th day of January, 2024, the described corner was evidenced by a 2" red & white
iron pipe

and to perpetuate the location of said corner, at the exact location thereof, a permanent marker was placed consisting of a 2"x 2"x 6' Telspar w/ aluminum cap and punch mark set up 0.5'± in
same location replacing found iron pipe rusted off up 0.6'±, which was removed.

AND on the 29th day of Janarary, 2024, said permanent marker was measured with RTK GPS
method to verify location and ties were updated after setting.

Updated reference ties are as shown below.

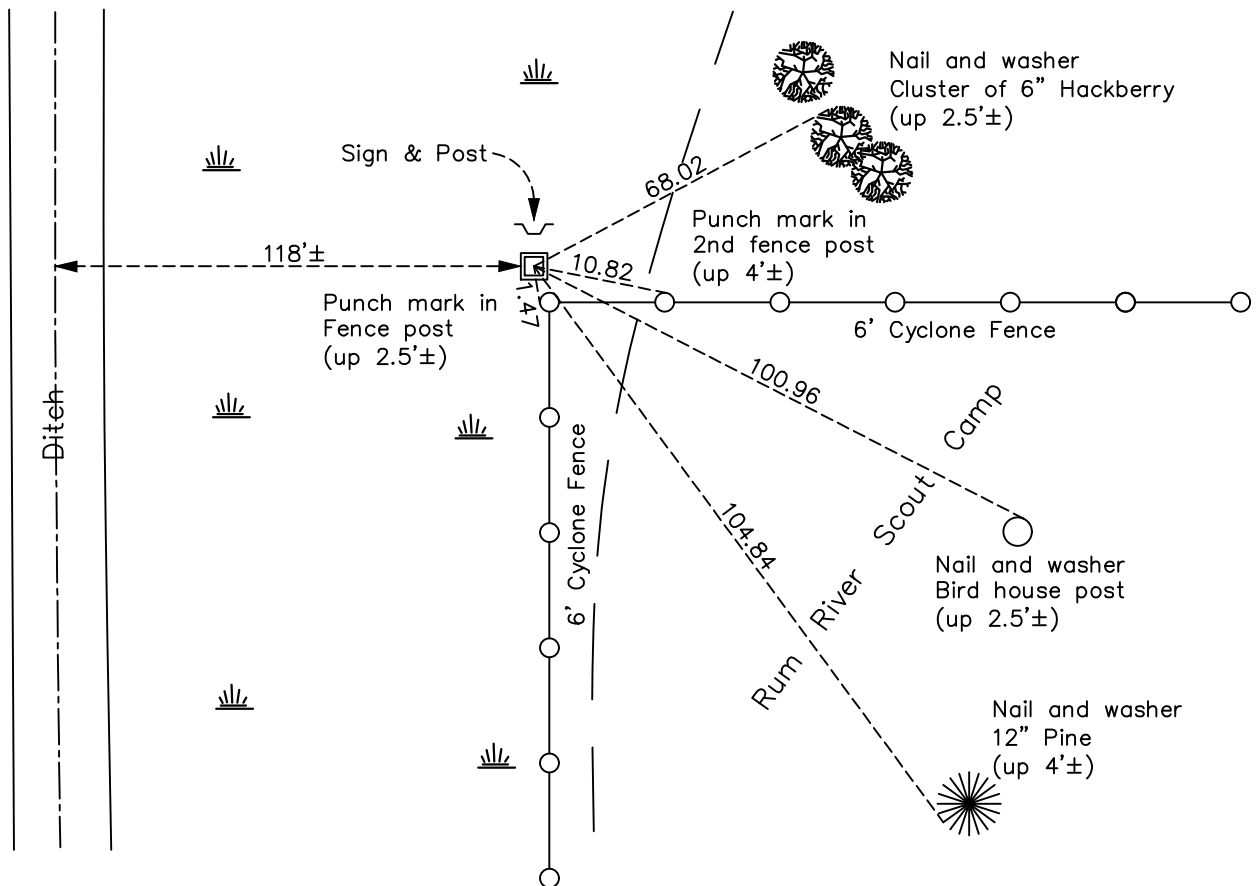

Revision Date

3/25/2024

N.A.D. 1983 Coordinates
(1996 Adjustment)

County Project Coordinates	
Northing	183029.8471
Easting	463378.0952
Date	4/13/00

I hereby certify that this United States public land survey monument record is correct and complete to the best of my knowledge and belief.

David Zieglmeier Date 3/28/24

David Zieglmeier Anoka County Surveyor
Minnesota License Number 46179

HISTORY OF GOVERNMENT CORNER

Page No. 65

County of Anoka

State of Minnesota

West 1/4 Corner of Sec. 13 Township 32 Range 25

CORNER HISTORY:

July 1850 - This corner was established by John Ryan, Deputy Surveyor. Ryan marked this position by "set quarter section post" with one bearing tree marked as an accessory.

May 9, 1967 - Set red and white 2"x8' iron pipe up 4'± using area resurvey and established ties to iron pipe.

6/24/69, 6/30/76, 3/17/77, 7/5/79, 8/23/82, 7/30/85, 7/12/88 - Found red and white iron pipe and updated ties.

April 13, 2000 - Found red and white iron pipe and established NAD 1983 (1996 Adjustment) Anoka County Project Coordinates by Static GPS methods. Updated ties.

5/27/10, 10/1/15 - Found red and white iron pipe rusted off 0.6'± above ground and updated ties.

10/9/20, 9/30/22 - Found red and white iron pipe rusted off 0.6'± above ground. Verified position by VRS GPS methods. Updated ties.

January 29, 2024 - Found 1.5" pipe rusted off at ground; removed. Replaced with 2"x 2"x 6' Telspar with 'County Surveyor' cap and punch mark, set up 0.5'±. Set to published coordinates using RTK GPS method and historical ties. Updated ties after setting. Added sign and post to north side, facing north. Job #24-100