CERTIFICATE OF LOCATION OF GOVERNMENT CORNER

County of Anoka

State of Minnesota


<u>Witness</u> Corner of Sec. <u>24</u> Township <u>32</u> Range <u>25</u> (On east line of section)

On the 20th day of September, 1963, the described corner was evidenced by area resurvey

and to perpetuate the location of said corner, at the exact location thereof, a permanent marker was placed consisting of a cast iron monument

AND on the 15th day of February, 2023, said permanent marker was found flush and leaning, adjusted to published coordinates using County RTK GPS method and updated the ties

Updated reference ties are as shown below.

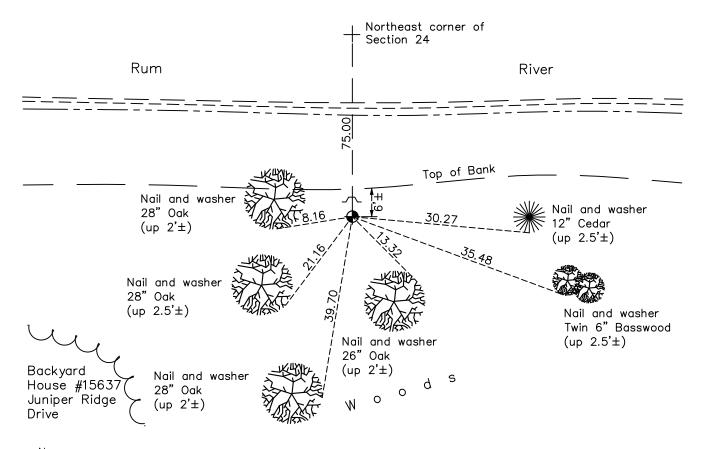



N.A.D. 1983 Coordinates (1996 Adjustment)

County Project Coordinates	
Northing	180327.9915
Easting	468603.5981
Date	4/21/00

I hereby certify that this United States public land survey monument record is correct and complete to the best of my knowledge and belief. Date 2/22/23

David Zieglmeier Anoka County Surveyor Minnesota License Number 46179

HISTORY OF GOVERNMENT CORNER

County of Anoka

State of Minnesota

<u>Witness</u> Corner of Sec. <u>24</u> Township <u>32</u> Range <u>25</u> (On east line of section)

CORNER HISTORY:

September 20, 1963 — Set cast iron monument using area resurvey and established ties to monument.

August 18, 1982 — Found cast iron monument and updated ties.

July 26, 1985 — Found cast iron monument and updated ties.

July 12, 1988 — Found cast iron monument and updated ties.

April 21, 2000 — Found cast iron monument with a sign and post on the north side and established NAD 1983 (1996 Adjustment) Anoka County Project Coordinates by Static GPS methods. Updated ties.

May 24, 2010 — Found cast iron monument flush with the surface and updated ties.

October 14, 2015 — Found cast iron monument flush with the surface with a sign and post on the north side and updated ties.

May 1, 2020 — Found cast iron monument flush with the surface with a sign and post on the north side and updated ties.

October 18, 2022 — Found cast iron monument flush with the surface with a sign and post on the north side and updated ties. Verified location of corner by VRS GPS methods.

February 15, 2023 — Found cast iron monument flush and leaning and adjusted to published coordinates. Verified adjusted position as correct by County RTK GPS method and updated the ties.