

CERTIFICATE OF LOCATION OF GOVERNMENT CORNER

County of Anoka

State of Minnesota


Witness Corner of Sec. 20 Township 32 Range 25
(On north line of section)

On the 14th day of June, 1968, the described corner was evidenced by area resurvey

and to perpetuate the location of said corner, at the exact location thereof, a permanent marker was placed consisting of a cast iron monument

AND on the 4th day of October, 2022, said permanent marker was found flush with a sign and post on the north side and the ties were updated

Updated reference ties are as shown below.

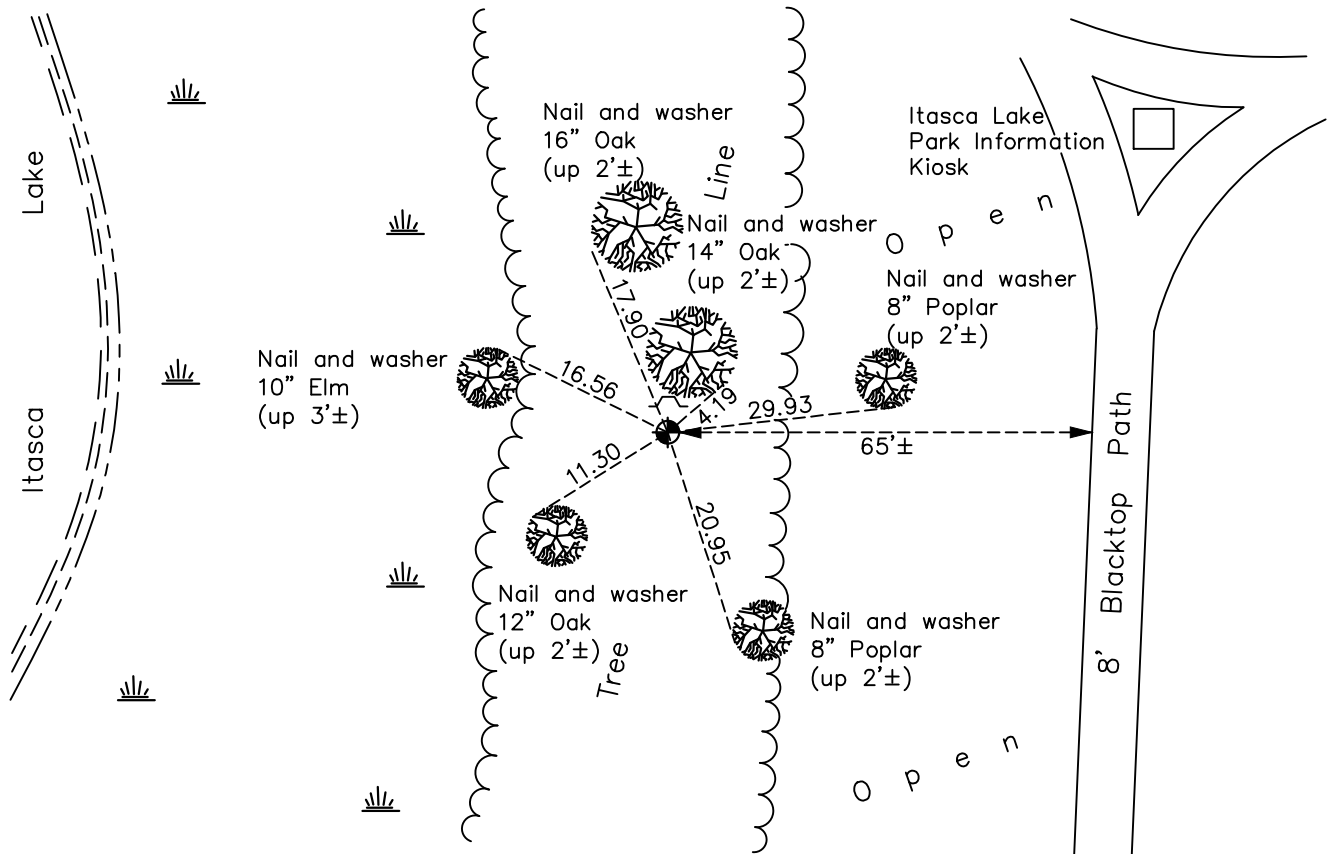

Revision Date
1/04/2023

N.A.D. 1983 Coordinates
 (1996 Adjustment)

County Project Coordinates	
Northing	<u>180494.8022</u>
Easting	<u>443350.9312</u>
Date	<u>4/24/00</u>

I hereby certify that this United States public land survey monument record is correct and complete to the best of my knowledge and belief.
David Zieglmeier Date 2/22/23
 David Zieglmeier Anoka County Surveyor
 Minnesota License Number 46179

HISTORY OF GOVERNMENT CORNER

Page No. 78

County of Anoka

State of Minnesota

Witness Corner of Sec. 20 Township 32 Range 25
(On north line of section)

CORNER HISTORY:

June 14, 1968 – Set cast iron monument flush with the surface using area resurvey and established ties to monument.

June 13, 1969 – Found cast iron monument and updated ties.

August 1, 1972 – Found cast iron monument and updated ties.

1977 – Found cast iron monument and updated ties.

July 5, 1979 – Found cast iron monument and updated ties.

August 16, 1982 – Found cast iron monument and updated ties.

June 29, 1988 – Found cast iron monument and updated ties.

August 18, 1993 – Found cast iron monument and updated ties.

May 9, 1996 – Found cast iron monument with a sign and post on the north side and updated ties.

April 24, 2000 – Found cast iron monument with a sign and post on the north side and established NAD 1983 (1996 Adjustment) Anoka County Project Coordinates by Static GPS methods. Updated ties.

June 7, 2010 – Found cast iron monument flush with the surface with a sign and post on the north side and updated ties.

September 10, 2015 – Found cast iron monument with a sign and post on the north side and updated ties.

March 30, 2020 – Found cast iron monument with a sign and post on the north side and updated ties.

October 4, 2022 – Found cast iron monument with a sign and post on the north side and updated ties. Verified position of corner by GPS VRS method.