

# CERTIFICATE OF LOCATION OF GOVERNMENT CORNER

County of Anoka

State of Minnesota



## East 1/4 Corner of Sec. 29 Township 32 Range 25

On the 4th day of November, 2016, the described corner was evidenced by a concrete monument

and to perpetuate the location of said corner, at the exact location thereof, a permanent marker was placed consisting of a Cast Iron Monument

AND on the 11th day of October, 2022, said permanent marker was found down 0.3' and the ties were updated

Updated reference ties are as shown below.

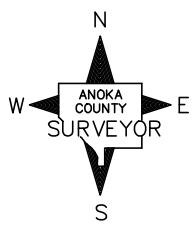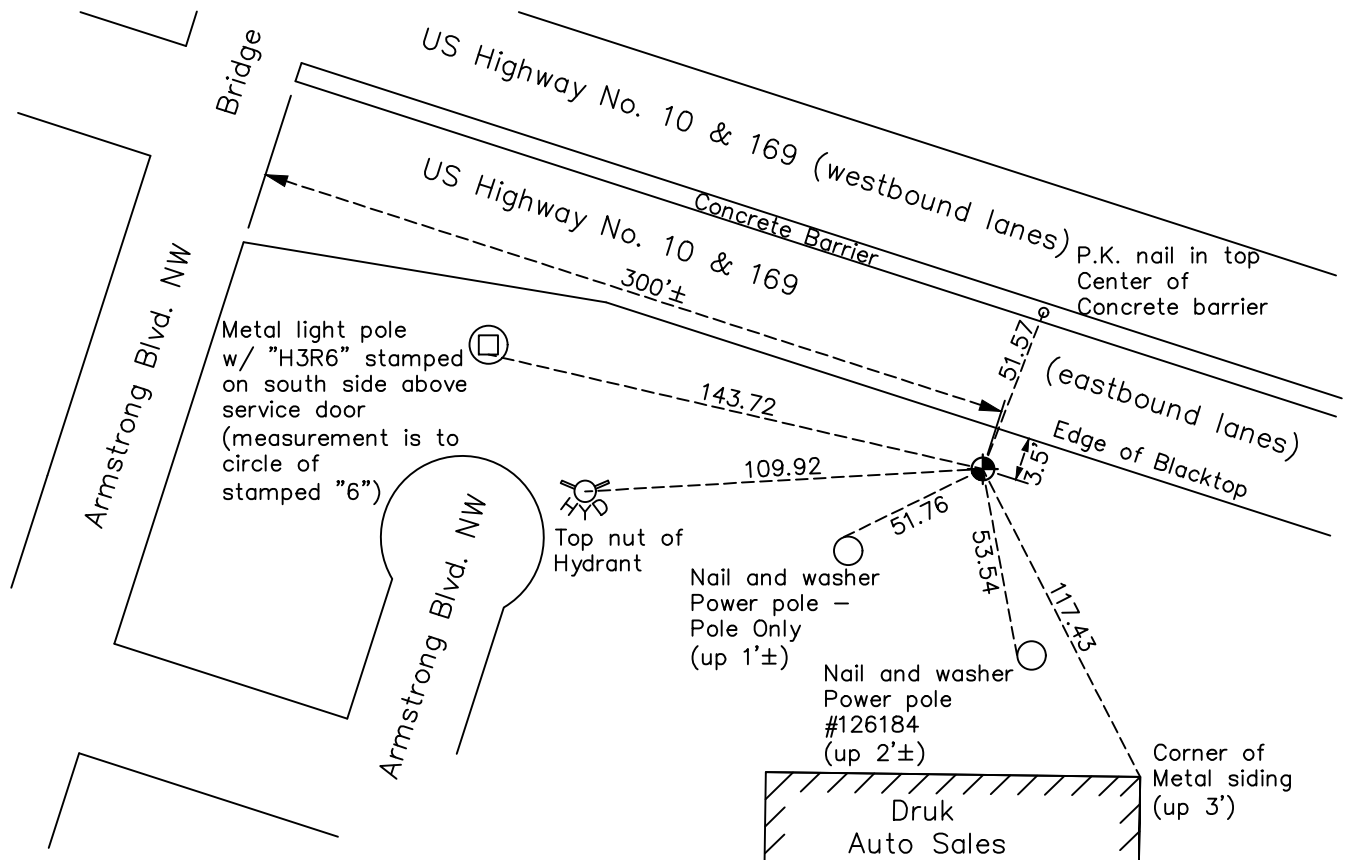

Revision Date  
1/06/2023

N.A.D. 1983 Coordinates  
(1996 Adjustment)

County Project Coordinates	
Northing	<u>172474.0871</u>
Easting	<u>447540.6458</u>
Date	<u>5/09/00</u>

I hereby certify that this United States public land survey monument record is correct and complete to the best of my knowledge and belief.

*David Zieglmeier* Date 2/22/23

David Zieglmeier Anoka County Surveyor  
Minnesota License Number 46179

# HISTORY OF GOVERNMENT CORNER

Page No. 107

County of Anoka

State of Minnesota

## East 1/4 Corner of Sec. 29 Township 32 Range 25

### **CORNER HISTORY:**

September 14, 1943 – Cartwright found concrete monument down 6" established ties to monument.

April 20, 1961 – Found concrete monument down 0.6'± in centerline of highway ditch and updated ties. Set 1/2" iron pipes on east and west sides of monument.

August 7, 1964 – Found concrete monument and updated ties.

June 20, 1969 – Found concrete monument down 1'± and updated ties.

August 7, 1972 – Found concrete monument and updated ties.

June 25, 1979 – Found concrete monument and updated ties.

August 16, 1982 – Found concrete monument and updated ties.

July 19, 1985 – Found concrete monument and updated ties.

June 27, 1988 – Found concrete monument and updated ties.

August 10, 1993 – Found concrete monument and updated ties.

May 9, 2000 – Found concrete monument and established NAD 1983 (1996 Adjustment) Anoka County Project Coordinates by Static GPS methods. Found 1" iron pipe on north side and updated ties.

April 21, 2010 – Found concrete monument down 1.5'± with a 1" iron pipe on the east side and updated ties. Set a sign and post on the north side of monument.

October 8, 2015 – Found concrete monument missing due to road construction.

November 4, 2016 – Reset position of corner with a cast iron monument using ties and verified position by Static GPS methods.

March 18, 2020 – Found cast iron monument down 0.3± and the position was verified by VRS GPS methods. Ties were updated.

October 11, 2022 – Found cast iron monument down 0.3'±, verified the position by VRS GPS method and the ties were updated.