

CERTIFICATE OF LOCATION OF GOVERNMENT CORNER

County of Anoka


State of Minnesota

CENTER Corner of Sec. 27 Township 32 Range 25

I hereby certify that on the 5 day of JANUARY, 1961, I found the described corner which was evidenced by 2" IRON PIPE

and I further certify that to perpetuate the location of said corner, I did, at the exact location thereof, place a permanent marker consisting of SAME

which reference or witness monuments are located in the manner following:

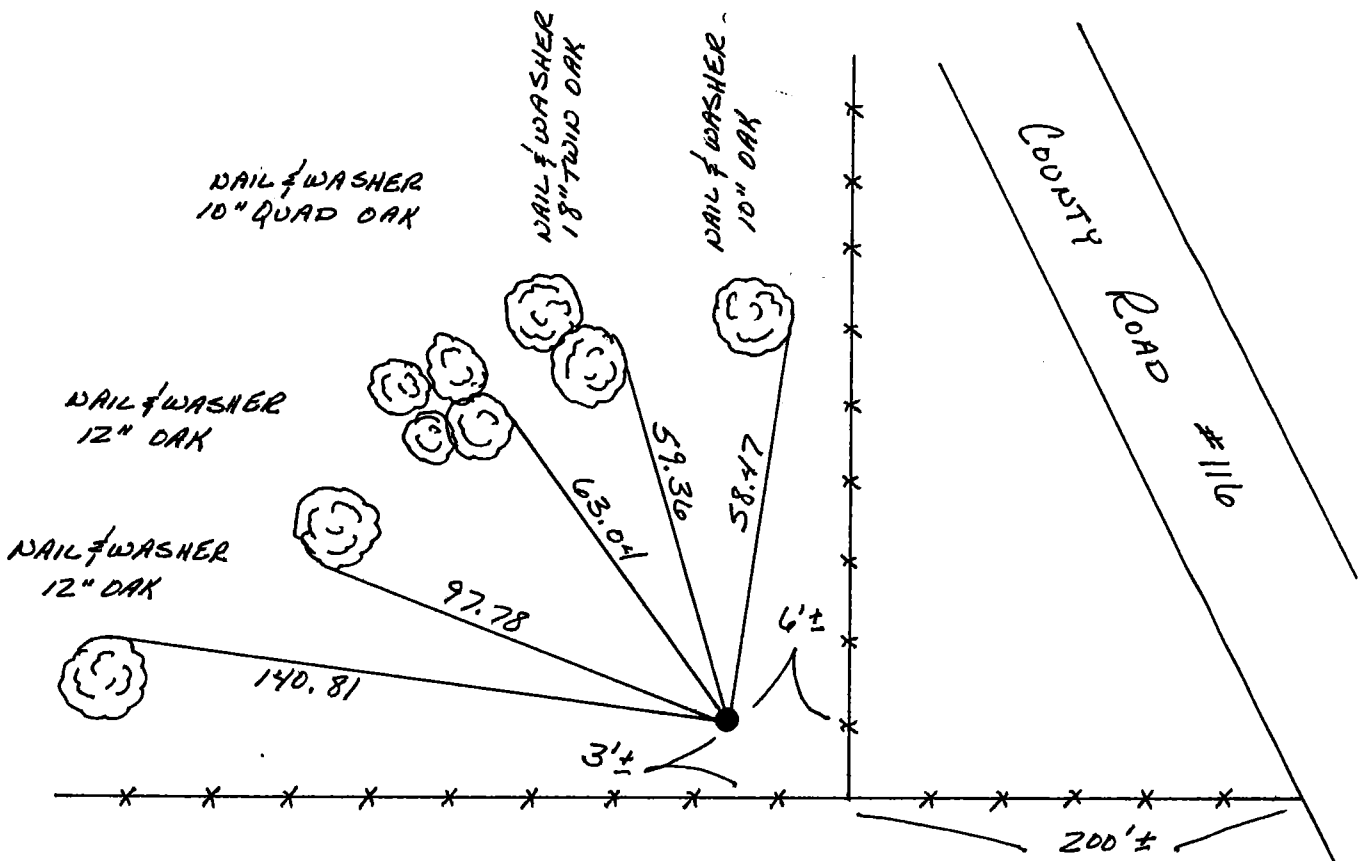

FENCES ARE OLD
AND MOSTLY DOWN

Revised date	Revised date	Revised date
6-30-69		
7-8-76		
6-25-79		
8-12-82		
7-26-85		
6-28-88		

